

SEP 14 1999

1998 CHEBOYGAN COUNTY, STATE OF MICHIGAN REMONUMENTATION

SECTION

LAND CORNER RECORDATION CERTIFICATE
Filing Requirement of Act 74, Mich. P.A. 1970

For corners in

Cheboygan
(County)

Located in:

Corner Code #

Forest Township

1. Public Land Survey

Waverly township

T 34N R 1E

T 35N R 1E

T R

T R

2. Property Controlling
in Section

3. Miscellaneous

Property in Sec.

S

S

S

S

T

T

T

T

T R

E-1
E-13

RECEIVED FOR RECORD 12-7-98
at 9:34 O'Clock A M

Joanne Gray

CLERK/REGISTER
CHEBOYGAN COUNTY, MICHIGAN

Register of Deeds Stamp & File Number

4. Lot No. , Recorded Plat

5. Private Claims

I, Ronald Bischer, in a field survey on 7-15, 1998 do hereby state that under requirements of P.A. 74, Michigan P.A. of 1970, the corner points mentioned in lines 1 and 2 above were in conformance with regulations and rules therefore as required in the current manual of survey instructions of the United States Department of the Interior, Bureau of Land Management or by a decree of a Court of Law and/or that the corner points mentioned in lines 3, 4 and 5 above were in conformance with the rules of the Michigan Board of Land Surveyors or by a Decree of a Court of Law; established, re-established, monumented, recovered, found as expressed below:


NOTE: Not more than 2 corners, all in the same town and range, may be recorded on this certificate.

	A	B	C	D	E	F	G	H	I	J	K	L	M
1													
2	6		5		4		3		2		1		
3													
4	7		8		9		10		11		12		
5													
6	18		17		16		15		14		13		
7													
8	19		20		21		22		23		24		
9													
10	30		29		28		27		26		25		
11													
12	31		32		33		34		35		36		
13													

A. Description of original monument and accessories and/or subsequent restoration:

E-1
1840 John Hodgson
1855 GLO Notes George Cannon (resurvey)
Set wood post
4 witnesses
June 12, 1978 Ronald Bischer #22428
set 1/2" rod by S.P.
3 witnesses

June 15, 1978 Delmer Porter #15410
1/2" rod and cap and 3 witnesses

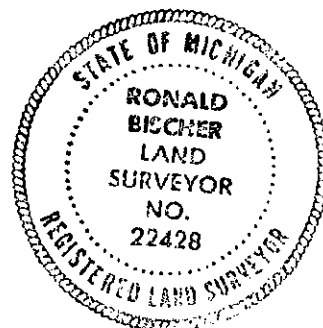


B. Description of corner evidence found and/or method applied in restoring or reestablishing corner:

E-1
Found 1/2" rod and cap and 3 witnesses
Replaced with 5/8" rod and remon cap

C. Description of monument for corner and accessories established to perpetuate locating the position of the corner:

E-1
5/8" rod and remon cap
S56°E 51.52' 21" Maple O.W.
S32°W 43.06' 17" Maple O.W.
N13°W 44.05' 13" Red pine O.W.
S87°E 9.35' 6" Spruce

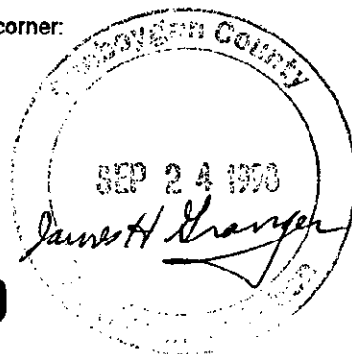

LIBER 011 PAGE 99

Signed by Ronald R. Bischer

Date Sept. 28, 1998

Surveyor's Michigan License No. 22428