

RECEIVED  
FOR RECORD

99 DEC 27 PM 4: 10

LAND CORNER RECORDATION CERTIFICATE  
Filing Requirement of Act 74, Mich. P.A. 1970

For corners in

Cheboygan  
(County)

Located In:

Corner Code #

## 1. Public Land Survey

T 34 N R 1 E E-4T     R    T     R    T     R    2. Property Controlling  
in SectionS     T     R    S     T     R    3. Miscellaneous  
Property in Sec.S     T     R    S     T     R    4. Lot No.       , Recorded Plat       5. Private Claims       

I, Ronald Bischer, in a field survey on Aug. 12, 1999 do hereby state that under requirements of P.A. 74, Michigan P.A. of 1970, the corner points mentioned in lines 1 and 2 above were in conformance with regulations and rules therefore as required in the current manual of survey instructions of the United States Department of the Interior, Bureau of Land Management or by a decree of a Court of Law and /or that the corner points mentioned in lines 3, 4 and 5 above were in conformance with the rules of the Michigan Board of Land Surveyors or by a Decree of a Court of Law; established, re-established, monumented, recovered, found as expressed below:

NOTE: Not more than 2 corners, all in the same town and range, may be recorded on this certificate.

	A	B	C	D	E	F	G	H	I	J	K	L
1												
2	6			5		4		3		2		1
3												
4	7			8		9		10		11		12
5												
6	18			17		16		15		14		13
7												
8	19			20		21		22		23		24
9												
10	30			29		28		27		26		25
11												
12	31			32		33		34		35		36
13												

## A. Description of original monument and accessories and/or subsequent restoration:

E-4

1855 GLO Notes Resurvey

S89°E 19 lks 10" Sugar

N87°W 17 lks 13" Sugar

Nov 25, 1908 David Bowen

4" Sq.cedar post in centerline of N/S road

Jan 17, 1975 Delmer Porter #15410

fnd. 1½" pipe in road centerline

S83°E 37.70' 8" Cedar

S62°W 38.17' p. Pole

N85°W 30.68' Fence corner

## B. Description of corner evidence found and/or method applied in restoring or reestablishing corner:

E-4

Aug. 12, 1999 Cheboygan County Remonumentation

Ronald Bischer #22428

found 1½" pipe set 5/8" rod inside pipe

found 1 old witness

set three new witnesses

## C. Description of monument for corner and accessories established to perpetuate locating the position of the corner:

E-4


5/8" rod and cap #22428 inside 1½" pipe

S77°E 37.70' 12" Cedar

S65°W 38.17' P. Pole

N23°E 95.82' 5" Elm

S46°E 35.03' cor. split rail fence

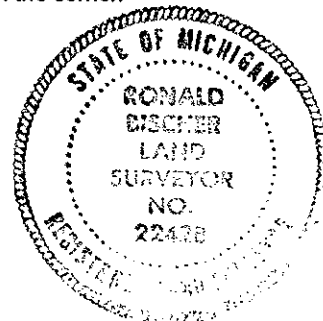

LIBER 011 PAGE 167

Signed by Ronald E. BischerDate 12-18-99Surveyor's Michigan License No. 22428