

RECEIVED
FOR RECORD

99 DEC 27 PM 4: 08

LAND CORNER RECORDATION CERTIFICATE
Filing Requirement of Act 74, Mich. P.A. 1970

For corners in

Cheboygan
(County)

Located In:

Corner Code #

1. Public Land Survey

T 34 N R 1 E H-5T R T R T R 2. Property Controlling
in SectionS T R S T R 3. Miscellaneous
Property in Sec.S T R S T R CLERK/REGISTER
CHEBOYGAN COUNTY MICHIGAN

RF

MAR 03 2000

SECTION
Register of Deeds Stamp & File Number4. Lot No. , Recorded Plat 5. Private Claims

I, Ronald Bischer, in a field survey on Aug. 13, 1999 do hereby state that under requirements of P.A. 74, Michigan P.A. of 1970, the corner points mentioned in lines 1 and 2 above were in conformance with regulations and rules therefore as required in the current manual of survey instructions of the United States Department of the Interior, Bureau of Land Management or by a decree of a Court of Law and/or that the corner points mentioned in lines 3, 4 and 5 above were in conformance with the rules of the Michigan Board of Land Surveyors or by a Decree of a Court of Law; established, re-established, monumented, recovered, found as expressed below:

NOTE: Not more than 2 corners, all in the same town and range, may be recorded on this certificate.

	A	B	C	D	E	F	G	H	I	J	K	L	M
1													
2	6		5		4			3		2		1	
3													
4	7		8		9			10		11		12	
5													
6	18		17		16			15		14		13	
7													
8	19		20		21			22		23		24	
9													
10	30		29		28			27		26		25	
11													
12	31		32		33			34		35		36	
13													

A. Description of original monument and accessories and/or subsequent restoration:

H-5

1855 GLO Notes Resurvey
N33° E 441ks 10" W. Pine
S20° W 341ks 7" Y. Pine

June 9, 1995 Ronald Bischer #22428
found $\frac{1}{2}$ " rod
East 33.60' fence corner
N48° W 42.94' T. Pole
S31° W 76.13' 10" Maple
S44° E 85.97' 10" Spruce

B. Description of corner evidence found and/or method applied in restoring or reestablishing corner:

H-5

Aug. 13, 1999 Cheboygan County Remonumentation
Ronald Bischer #22428
found $\frac{1}{2}$ " rod in mon box placed remon cap on top
found 2 old witnesses
set 2 new witnesses




C. Description of monument for corner and accessories established to perpetuate locating the position of the corner:

H-5

 $\frac{1}{2}$ " rod and remon cap #22428 in mon box

S31° W 76.13' 11" Maple
S44° E 85.97' 11" Spruce
East 33.60' Fence Cor.
N35° W 60.50' 7" Birch in clump

LIBER 011 PAGE 166

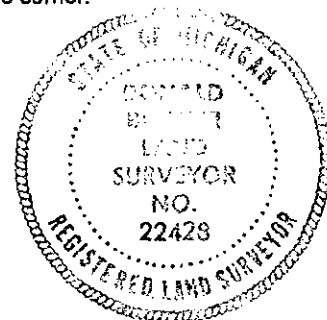

Signed by Ronald R. Bischer
Surveyor's Michigan License No. 22428

Date 12-18-99