

RECEIVED
FOR RECORD

99 DEC 27 PM 3:47

1999 CHEBOYGAN COUNTY REMONUMENTATION

LAND CORNER RECORDATION CERTIFICATE
Filing Requirement of Act 74, Mich. P.A. 1970

For corners in

Cheboygan
(County)

Located In:

Corner Code #

1. Public Land Survey

T 34N R 1E M-2
T 34N R 2E H-2
T R
T R
T R
S T R
S T R
S T R
S T R

2. Property Controlling
in Section

3. Miscellaneous
Property in Sec.

4. Lot No. _____, Recorded Plat _____
5. Private Claims _____

I, Ronald Bischer, in a field survey on Aug. 10 1999 do hereby state that under requirements of P.A. 74, Michigan P.A. of 1970, the corner points mentioned in lines 1 and 2 above were in conformance with regulations and rules therefore as required in the current manual of survey instructions of the United States Department of the Interior, Bureau of Land Management or by a decree of a Court of Law and/or that the corner points mentioned in lines 3, 4 and 5 above were in conformance with the rules of the Michigan Board of Land Surveyors or by a Decree of a Court of Law; established, re-established, monumented, recovered, found as expressed below:

NOTE: Not more than 2 corners, all in the same town and range, may be recorded on this certificate.

Deby Pyzyrski
CLERK/REGISTER
CHEBOYGAN COUNTY MICHIGAN

RECEIVED
MAR 03 2000

Register of Deeds Stamp & File Number

| | A | B | C | D | E | F | G | H | I | J | K | L | M |
|----|----|---|----|---|----|---|----|---|----|---|----|---|---|
| 1 | | | | | | | | | | | | | |
| 2 | 6 | | 5 | | 4 | | 3 | | 2 | | 1 | | |
| 3 | | | | | | | | | | | | | |
| 4 | 7 | | 8 | | 9 | | 10 | | 11 | | 12 | | |
| 5 | | | | | | | | | | | | | |
| 6 | 18 | | 17 | | 16 | | 15 | | 14 | | 13 | | |
| 7 | | | | | | | | | | | | | |
| 8 | 19 | | 20 | | 21 | | 22 | | 23 | | 24 | | |
| 9 | | | | | | | | | | | | | |
| 10 | 30 | | 29 | | 28 | | 27 | | 26 | | 25 | | |
| 11 | | | | | | | | | | | | | |
| 12 | 31 | | 32 | | 33 | | 34 | | 35 | | 36 | | |
| 13 | | | | | | | | | | | | | |

A. Description of original monument and accessories and/or subsequent restoration:

M-2

1840 GLO Notes

S28°W 15 lks 12" Cedar
N75°W 32 lks 18" Cedar

Oct. 4, 1909 David Bowen
4" sq. cedar post on east side of N/S
road driven in marsh lands

Nov. 1, 1990

Ronald Bischer #22428

½" rod and cap

South 45.90' RxR

S45°W 34.92' RxR sign

N89°W 48.61' Fence Corner

B. Description of corner evidence found and/or method applied in restoring or reestablishing corner:


M-2

Aug. 10, 1999 Cheboygan County Remonumentation

Ronald Bischer #22428

found ½" rod replaced with 5/8" rod and cap #22428

found only 1 old witness

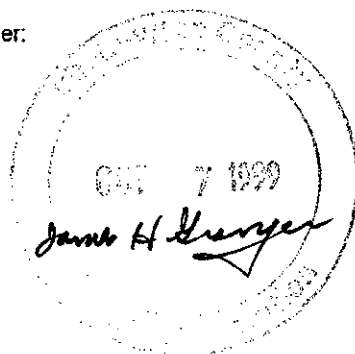

C. Description of monument for corner and accessories established to perpetuate locating the position of the corner:

M-2

5/8" rod and cap #22428


S87°E 51.35' 3" Cedar

S55°E 33.33' 5" Aspen

S42°W 42.17' 4" Ash

N88°W 48.61' Fence Corner

LIBER 011 PAGE 161

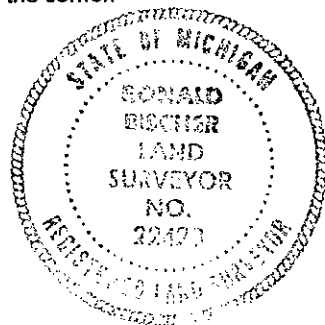

Signed by Ronald R. Bischer
Surveyor's Michigan License No. 22428

Date 12-18-99