


LAND CORNER RECORDATION CERTIFICATE
Filing Requirement of Act 74, Mich. PA 1970

For Corners In:
Cheboygan
(County)
Located In
Corner Code #
1. Public Land Survey T 34N R 1W K-5
2. Property Controlling in Section S T R
3. Miscellaneous Property in Section S T R
4. Lot No: Recorded Plat:
5. Private Claims:

I, Carl T. Kiiskila, in a field survey on April 28, 2010 do hereby state that under requirements of PA 74, Michigan PA of 1970, the corner points mentioned in lines 1 and 2 above were in conformance with regulations and rules therefore as required in the current manual of survey instructions of the United States Department of the Interior, Bureau of Land Management or by a decree of a Court of Law and/or that the corner points mentioned in lines 3, 4 and 5 above were in conformance with the rules of the Michigan Board of Land Surveyors or by a Decree of a Court of Law; established, re-established, monumented, recovered, found as expressed below:

NOTE: Not more than 2 corners, all in the same town and range, may be recorded on this certificate.

Register of Deeds Stamp & File Number

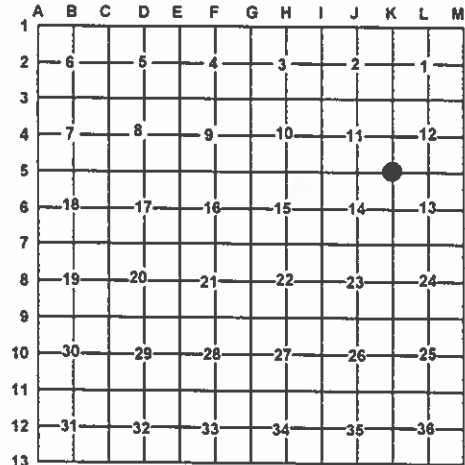

A. Description of original monument and accessories and/or subsequent restoration:

K-5 - Section cor. comm.. to sec.'s 11,12,13,14, T34N,R1W

- 1850 - GLO - Austin Burt - Set post corner of sec.'s 11-12-13 & 14 Cedar 8 S62°E 09 links Hemlock 12 N66°W 05 links
- 1966 - Land Corner Record - L.A,p159 - Kenneth J. Ostling, P.S.#10068 - This cor. was est. while making a survey in this township. Set cor. by proportionate measurement for lat., at double distances from 1/4 and sec. corner east. This method conforms to occupation north and west, follows very nearly along fence line east and checks U.S. record to physical features south. Set 3/4"x24" iron bar. Corner fence post S80°E 35.4'; Corner fence post S40°W 45.5'
- 1985 - L.C.R.C. - L.1,p.330A - Delmer E. Porter, P.S.#15410 - Fd. DNR cor. and one witness. S37°W 45.15' Fe. Cor.; S86°E 36.44' Fe. Cor.; N35°W 62.69' Fe. Cor.

B. Description of corner evidence found and/or method applies in restoring or re-establishing corner:

K-5 - Section cor. comm.. to sec.'s 11,12,13,14, T34N,R1W

Found 5/8"x 1.55' long iron bar badly bent and lying over on side. Doubled over K3 and K4 to north to reset position of section corner. Corner fits c/l gravel road to west and fence line to east. Corner is 2' west of N-S c/l gravel road. Set standard DNR monument at position of corner. Set corner accepted as a careful and faithful reestablishment of the position of the original corner. Found no other evidence to dispute the location for the corner.

C. Description of monument for corner and accessories established to perpetuate locating the position of the corner:

K-5 - Section cor. comm.. to sec.'s 11,12,13,14, T34N,R1W

Stamped 4" dia. aluminum cap on 1"x 36" galvanized pipe.

- Witnesses:
- N44°E 65.77' to stamped 2" dia. alum. cap on 5/8"x 34" rebar (GPS Base station for the project)
 - N57°E 107.74' to set N&T on SE side 3" R.Pine
 - S66°E 95.03' to set N&T on SW side 6" Tamarack
 - S23°W 115.63' to set N&T on E side 3" Tamarack
 - N46°W 86.58' to set N&T on NE side 13" R.Pine
 - *S85°E 36.50' base of old fence post lying down
 - *S34°W 45.35' base of old leaning fence post
 - S56°E 5.62' found cabin spike



Signed by: Carl T Kiiskila Date: 6-15-10
Surveyor's Michigan License No.: 33981