

# *Walker* **SURVEY & REMONUMENTATION**

MAY 05 1997

RE MONUMENTATION

LAND CORNER RECORDATION CERTIFICATE  
Commission Filing Requirement of Act 74, Mich. P.A. 1970

RECEIVED  
FOR RECORD

96 NOV 25 PM 1:02

*Joanne Gray*  
CLERK/REGISTER  
CHEBOYGAN COUNTY, MICHIGAN

For corners in

**Cheboygan**

(County)

Located In:

Corner Code #

1. Public Land Survey

	34N	1W	M-2
T	R		
T	R		
T	R		
T	R		
S	T	R	
S	T	R	
S	T	R	
S	T	R	

2. Property Controlling in Section

3. Miscellaneous Property in Sec.

4. Lot No. \_\_\_\_\_, Recorded Plat \_\_\_\_\_  
5. Private Claims \_\_\_\_\_

I, Brian K. Fullford, in a field survey on August, 19 96 do hereby state that under requirements of P.A. 74, Michigan P.A. of 1970, the corner points mentioned in lines 1 and 2 above were in conformance with regulations and rules therefore as required in the current manual of survey instructions of the United States Department of the Interior, Bureau of Land Management or by a decree of a Court of Law and/or that the corner points mentioned in lines 3, 4 and 5 above were in conformance with the rules of the Michigan Board of Land Surveyors or by a Decree of a Court of Law; established, re-established, monumented, recovered, found as expressed below:

NOTE: Not more than 2 corners, all in the same town and range, may be recorded on this certificate.

A	B	C	D	E	F	G	H	I	J	K	L	M
1												
2	6		5		4		3		2		1	
3												
4	7		8		9		10		11		12	
5												
6	18		17		16		15		14		13	
7												
8	19		20		21		22		23		24	
9												
10	30		29		28		27		26		25	
11												
12	31		32		33		34		35		36	
13												

A. Description of original monument and accessories and/or subsequent restoration:  
G.L.O. 1961 LCRC Unrecorded Survey  
Set 1/4 Section Post Liber A, Page 128 By Doyle for Elmer Dubey  
7" Cedar S12°W 13 Links Dean DeLamater #5778  
7" Balsam N11°E 9 Links Fnd 1" Iron Pipe  
9" Cedar S62°E 22.5' 10" Elm N25°W 26.1'

B. Description of corner evidence found and/or method applied in restoring or reestablishing corner:  
Fnd 1" Iron Pipe  
9" Black Walnut S15°E 16.45' With Tag #15410  
9" Black Walnut South 21.20' With Tag #15410




LIBER 010 PAGE 204

C. Description of monument for corner and accessories established to perpetuate locating the position of the corner:

M-2 Fnd 1" Iron Pipe. Set 5/8" x 36" Rebar with Remonumentation Cap Inside. Accepted as a careful & faithful re-establishment of the position of the original corner.

10" Elm S84°E 17.69' Set Tag  
9" Black Walnut S15°E 16.45' Tag #15410  
9" Black Walnut South 21.20' Tag #15410  
4" Black Walnut N79°W 18.49' Set Tag

*Marvin A. Rice*

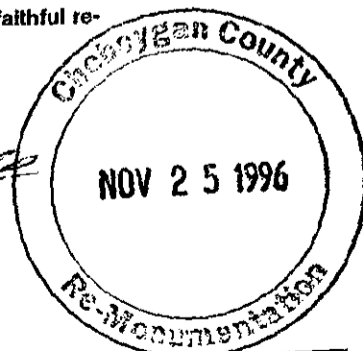

THIS CORNER IS ALSO DESIGNATED AS CORNER CODE #A-2, IN T34N-R1E.

Signed by

41099

Date

10/22/96

Surveyor's Michigan License No.

Brian K. Fullford, PS