

MICHIGAN
DEPARTMENT OF CONSERVATION
FORESTRY DIVISION

LAND CORNER RECORD

T. 34 N. R. 1 W


Cheboygan COUNTY

DESCRIPTION OF CORNER Sec. corner common to Sections 21-22-27-28

CORNER MONUMENT Set 1" pipe with 4" aluminum cap

DATE MONUMENT PLACED AND WITNESSED June 17, 1966

WITNESSES TO CORNER.....

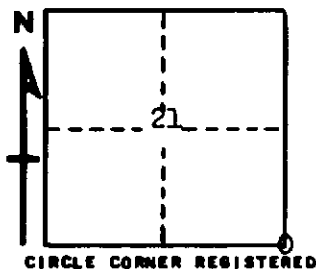

4" Spruce S 75 E 8.5'

5" Spruce S 39 W 4.9'

AND

DESCRIPTION IN DETAIL AS TO HOW CORNER WAS LOCATED AND IDENTIFIED OR RESTORED.

This corner was found while making a survey in this township. Found $1\frac{1}{2}$ " pipe by Schaaf at corner, with possible sites of USBTs in place. A Tamarack stub NW appears to be a witness and is dated 1888. Fits swamp edges good, and appears acceptable as proper location.

SURVEYOR'S SEAL

SIGNED Kenneth J. Ostling DATE June 20, 1966
REGISTERED LAND SURVEYOR #10068