

# LAND CORNER RECORDATION CERTIFICATE

Filing Requirement of Act 74, Mich. PA 1970

For Corners In:

Cheboygan

(County)

Located In

Corner Code #

1. Public Land Survey

T 34N R 3W D-3

2. Property Controlling  
in Section

S 5 T 34N R 3W 7

3. Miscellaneous  
Property in Section

S T R

4. Lot No:


Recorded Plat:

5. Private Claims:

I, Carl T. Kiiskila, in a field survey on March 12, 2008 do hereby state that under requirements of PA 74, Michigan PA of 1970, the corner points mentioned in lines 1 and 2 above were in conformance with regulations and rules therefore as required in the current manual of survey instructions of the United States Department of the Interior, Bureau of Land Management or by a decree of a Court of Law and/or that the corner points mentioned in lines 3, 4 and 5 above were in conformance with the rules of the Michigan Board of Land Surveyors or by a Decree of a Court of Law; established, re-established, monumented, recovered, found as expressed below:

**NOTE: Not more than 2 corners, all in the same town and range, may be recorded on this certificate.**

Register of Deeds Stamp & File Number

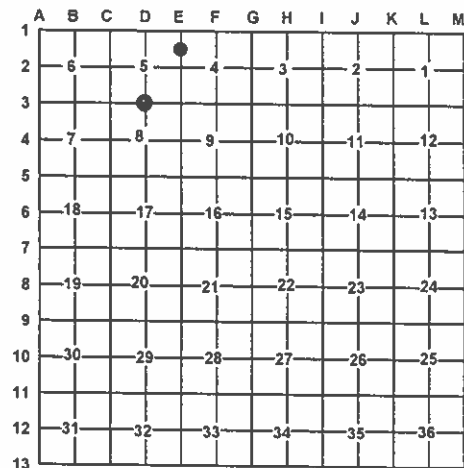

A. Description of original monument and accessories and/or subsequent restoration:

7-This corner position was not established in the original Government Survey.

D-3 1840 G.L.O. C.W. Cathcart, set ¼ section post.  
Wits: 10" Hemlock N20°E 6 links  
18" Hemlock S60°W 14 links

May 2002 Brian Fullford P.S. #41099 found a ½" bar w/P.S. cap #12020.

Wits: 18" Maple S57°E 28.35'  
10" Tri Maple S40°W 32.00'  
10" Beech N84°W 11.18'  
12' Beech N16°W 7.17'

B. Description of corner evidence found and/or method applies in restoring or re-establishing corner:

7-Established the Southeast corner of the Northeast quarter of the Northeast quarter of section 5 as per B.L.M. instructions for the subdivision of a section.

D-3 Found a ½" bar fitting B. Fullford's survey and witnesses in section 5.

C. Description of monument for corner and accessories established to perpetuate locating the position of the corner:

7-Set 5/8" x 32" rerod with P.S. cap #33981

Wits: N&T SW side 6" Maple N63°W 10.15'  
N&T NE side 7" Ironwood N16°W 20.17'  
N&T NE side 8" Maple S46°E 24.49'  
N&T NW side 6" Maple S53°W 38.23'  
½" iron rod w/P.S. cap #12020 East 1.34'

D-3 Set standard DNR monument in place of found ½" bar

Wits: N&T S side 8" Beech N76°W 11.22'  
N&T E side 9" Beech N05°W 7.45'  
N&T N side 16" Maple S50°E 28.55'  
N&T NW side 13" Maple S46°W 31.97'

Signed by:

Carl T. Kiiskila

Date:

8-18-08

Surveyor's Michigan License No.:

33981

