


LAND CORNER RECORDATION CERTIFICATE
Filing Requirement of Act 74, Mich. PA 1970

For Corners In:
Cheboygan
(County)
1. Public Land Survey
2. Property Controlling in Section
3. Miscellaneous Property in Section
4. Lot No:
5. Private Claims:

I, Carl T. Kiiskila, in a field survey on April 22, 2008 do hereby state that under requirements of PA 74, Michigan PA of 1970, the corner points mentioned in lines 1 and 2 above were in conformance with regulations and rules therefore as required in the current manual of survey instructions of the United States Department of the Interior, Bureau of Land Management or by a decree of a Court of Law and/or that the corner points mentioned in lines 3, 4 and 5 above were in conformance with the rules of the Michigan Board of Land Surveyors or by a Decree of a Court of Law; established, re-established, monumented, recovered, found as expressed below:

NOTE: Not more than 2 corners, all in the same town and range, may be recorded on this certificate.

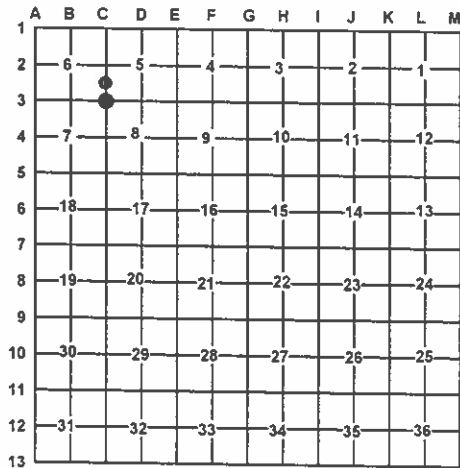

A. Description of original monument and accessories and/or subsequent restoration:
C-3 G.L.O. C.W. Cathcart 1840, Set post.
Wit: Hemlock 6" S80°E 35 links
Hemlock 6" S65°W 7 links
1961 K.J. Ostling found a 1 1/2" pipe for corner
Wits. 8" Cedar N 48°W 42.0'
7" Tamarack S73°W 76.42'
1976 Liber 1, Page 201 R. Bischer Fd 1 1/2" pipe
Wits: 10" Cedar N 51°W 65.65'
Cedar stump N 78°W 42.0'
12" Tamarack S73°W 76.35'
1989 Liber 2, Page 41 J. Granger Fd 1" pipe
Wits: P. Pole N29°E 98.45'
20" Elm S38°W 75.24'
20" Maple S6°E 122.42'
20" Maple N20°W 61.71'
10- This corner position was not established during the original government survey.

B. Description of corner evidence found and/or method applies in restoring or re-establishing corner:
C-3 Found 5/8" bar fitting R. Bisher's survey
10- Found 1/2" ID pipe fitting the proper subdivision of a section.

C. Description of monument for corner and accessories established to perpetuate locating the position of the corner:
C-3 Added P.S. cap# 33981 to found 5/8" bar
Wit: Nail and tag NE side of 9" Poplar S36°W 45.47'
Nail and tag S side of 18" Hemlock N78°W 36.97'
Nail and tag #41099 S side 12" Poplar N36°E 49.15'
Nail and tag SE side of 12" Cedar N34°W 51.66'
South edge metal f. post S77°E 31.74'
10- Added P.S. cap #33981 to found 1/2" ID pipe
Wit: Nail and tag south side of 4X6 post S83°E 40.11'
Centerline of road East 12'
Nail and tag East side of 4" Poplar S28°E 66.56'
Nail and tag South side of 3" Cherry N89°W 59.95'

Signed by: [Signature of Carl T. Kiiskila]
Surveyor's Michigan License No.: 33981

Date: 8-16-08

