

SURVEY & REMONUMENTATION

CHEBOYGAN COUNTY REMONUMENTATION CORNER

MAY 05 1997

LAND CORNER RECORDATION CERTIFICATE Filing Requirement of Act 74, Mich. P.A. 1970

For corners in
CHEBOYGAN
(County)

Located In:

Corner Code #

- | | | | | |
|------------------------------------|---|------|----|------|
| 1. Public Land Survey | T | 34NR | 3W | M-10 |
| | T | | R | |
| | T | | R | |
| | T | | R | |
| 2. Property Controlling in Section | S | T | R | |
| | S | T | R | |
| 3. Miscellaneous | S | T | R | |
| Property in Section | S | T | R | |
4. Lot No. _____, Recorded Plat _____
5. Private Claims _____

RECEIVED
FOR RECORD

96 OCT -1 PM 4:15

Joanne Spray
CLERK/REGISTER
CHEBOYGAN COUNTY, MICHIGAN

Register of Deeds Stamp & File Number

I, Ronald Bischer, in a field survey on August 30, 1996
do hereby certify that under requirements of P.A. 74, Michigan P.A. of 1970, the corner points mentioned in lines 1 and 2 above were in conformance with regulations and rules therefore as required in the current manual of survey instructions of the United States Department of the Interior, Bureau of Land Management or by a decree of a Court of Law and/or that the corner points mentioned in lines 3, 4 and 5 above were in conformance with the rules of the Michigan Board of Professional Surveyors or by a Decree of a Court of Law; established, re-established, monumented, re-monumented, recovered, found as expressed below:

NOTE: Not more than 4 corners, all in the same town and range, may be recorded on this certificate.

A. Description of original monument and accessories and/or subsequent restoration:

1840 GLO Survey - John Mullett
Set Wood Post
Sugar 7" S09° E 9 lks
Beech 6" N34° E 17 lks

1952 Orlando Doyle #7319
Set 3/4" pipe
Set two witnesses

B. Description of corner evidence found and/or method applied in restoring or reestablishing corner:

Found 3/4" pipe and Doyle's two witnesses

Set Cheboygan County Remonumentation Monument in 3/4" pipe



C. Description of monument for corner and accessories established to perpetuate locating the position of the corner:

Cheboygan County Remonumentation Monument

N66° W 12.44 18" Maple
N24° E 16.70' 3" Maple
S41° W 12.36' 10" Aspen
S67° W 30.52' 3" Balsam

LIBER 010 PAGE 160

Monni A. Rose

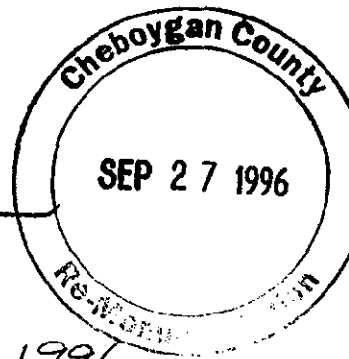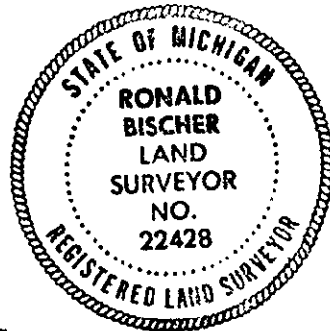

Signed by Ronald R. Bischer

Date Sept. 18, 1996

Surveyor's Michigan License No. 22428