

LAND CORNER RECORDATION CERTIFICATE

FILING REQUIREMENT OF ACT 74, MICH. P.A.1970

FOR CORNERS OF--	LOCATED IN--	CORNER CODE NUMBER
1. PUBLIC LAND SURVEY _____ T. 34 N. R. 3 W.		E-11; F-10; F-11
2. PROPERTY CONTROLLING IN SECTION 28, T. 34 N. R. 3 W.		8
3. MISCELLANEOUS PROPERTY IN SECTION _____, T. _____ N. S., R. _____ E. W.		
4. LOT NO. _____, RECORDED PLAT _____		
5. PRIVATE CLAIMS _____		

REGISTER OF DEEDS STAMP AND FILING NUMBER

I, Kenneth J. Ostling, do hereby certify that under requirements of P.A. 74, Michigan P.A. of 1970, the corner points mentioned in lines 1 and 2 above were, in a field survey on September 7, 1978, established, re-established, monumented, re-monumented, recovered or restored as expressed below and in conformance with regulations and rules therefore as required in the current manual of survey instructions of the United States Department of the Interior, Bureau of Land Management or by a decree of a court of law. Furthermore, that the corner points mentioned in lines 3, 4 and 5 above were, in a field survey on _____, 19____, found, recovered, restored, established or re-established as expressed below and in conformance with the rules of the Michigan State Board of Registration for Land Surveyors or, by a Decree of a Court of law:

A. Description of original monument and accessories and for subsequent restoration:

C. (continued)

8
Set 5/8"x40" Iron Bar w/RLS Cap
3" Maple N21°E 16.0
4" Maple N60°E 31.15


B. Description of corner evidence found and/or method applied in restoring or re-establishing corner:

- 11 Found 3/4" pipe at road intersection, origin unknown.
- 10 Found squared, scribed post in N-S fence line, probably as established in early county surveyor survey. Local resident Robert Vroman, first located stake in 1946, but was possibly 20 years old at that time. Falls some 14'W and 4'S of theoretical 1/4 line intersection, but has been accepted as corner by all adjoins residents.
- 11 Found 1/2" iron bar in road centerline, in line with fences N & S, origin unknown.
- 8 Set by standard survey procedure for subdivision of sections.

C. Description of monument for corner and accessories established to perpetuate locating the position of the corner:

E-11	F-10	F-11
Left 3/4" pipe in place	Fd. scribed post; set 5/8" Rod	Left 1/2" Iron Bar in Place
Nail & Ref. Tag in PP	w/RLS Cap & red-top post	Nail w/Cap in 10" Basswood
N38°W 47.78	6" Maple N73°W 28.35	S54°E 64.01
Nail & Ref. Tag in PP	4" Maple N02°W 18.3	Face of 2" Cherry
S31°W 27.74		S03°W 31.5

SIGNED BY Kenneth J. Ostling DATE 11-15-78
 SURVEYOR'S MICHIGAN REGISTRATION NO. 10068
 FOR STATE AND UNITED STATES AGENCIES:
 SIGNED BY _____ DATE _____
 CHIEF OF SURVEY PARTY
 APPROVED AND SIGNED BY _____ DATE _____
 MICHIGAN REGISTERED LAND SURVEYOR

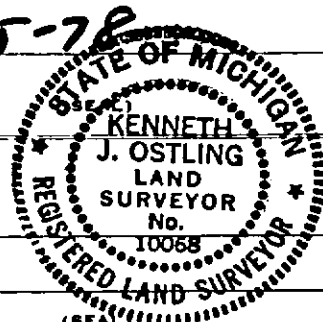

SURVEYOR'S MICHIGAN REGISTRATION NO. _____ CHEBOYGAN COUNTY

FORM APPROVED BY MICHIGAN STATE BOARD OF REGISTRATION, JAN. 28, 1971
 REVISED MAY 14, 1978

MAY PLACE SKETCH ON BACK OR ATTACHED SHEET