

# SURVEY & REMONUMENTATION

CHEBOYGAN COUNTY REMONUMENTATION CORNER

## LAND CORNER RECORDATION CERTIFICATE

Filing Requirement of Act 74, Mich. P.A. 1970

MAY 13 1995

DEC 29 1994

For corners in

Cheboygan  
(County)

COMMISSION

Located in:

Corner Code #

RECEIVED FOR RECORD

at 12:56 O'Clock P.M.

*Joanne Spragg*

CLERK/REGISTER

CHEBOYGAN COUNTY, MICHIGAN

Register of Deeds Stamp & File Number

1. Public Land Survey

T 35N R 1W

A-10

T R

T R

T R

2. Property Controlling  
in Section

S T R

S T R

3. Miscellaneous  
Property in Sec.

S T R

S T R

4. Lot No. , Recorded Plat

5. Private Claims

I, Richard C. Dunn, in a field survey on August, 19 94, do hereby certify that under requirements of P.A. 74, Michigan P.A. of 1970, the corner points mentioned in lines 1 and 2 above were in conformance with regulations and rules therefore as required in the current manual of survey instructions of the United States Department of the Interior, Bureau of Land Management or by a decree of a Court of Law and/or that the corner points mentioned in lines 3, 4 and 5 above were in conformance with the rules of the Michigan Board of Land Surveyors or by a Decree of a Court of Law; established, re-established, monumented, re-monumented, recovered, found as expressed below:

**NOTE: Not more than 4 corners, all in the same town and range, may be recorded on this certificate.**

A. Description of original monument and accessories and/or subsequent restoration:


G.L.O. John Mullett 1840  
Set wood post  
12" Maple S57°E 15 Links  
6" Beech N57°W 8 Links

Orlando Doyle #7319  
March 1974 Book 1, page 119  
Set 1" Pipe  
5" Elm N50°E 38.59'  
7" Twin Maple N20°W 59.74'  
8" Elm S88°E 59.12'

B. Description of corner evidence found and/or method applied in restoring or reestablishing corner:

Fnd. 1" Pipe (Bent) w/Doyle Cap #7319  
Fnd. 5" Elm N50°E 38.59' (Dead)  
Fnd. 8" Elm S88°E 59.12' (Dead)

*Marvin A. Ross*

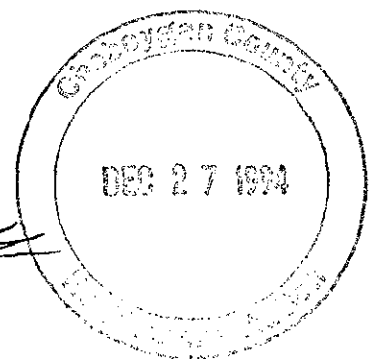

C. Description of monument for corner and accessories established to perpetuate locating the position of the corner:

A-10 Found 1" Pipe w/Doyle Cap #7319, replaced with 5/8" x 30" Iron Bar and 3" aluminum cap per Liber 1, Page 119, Cheboygan County Records, and is accepted as a careful and faithful reestablishment of the position of the original corner.  
4" Twin Cherry N50°W 33.50'  
10" Twin Apple S15°W 59.72'  
5" Ash S10°E 57.11'  
8" 24" Clump Basswood S85°E 55.96'  
Center Line-Cross Road

LIBER 010 PAGE 104

igned by

*Richard C. Dunn*

Date December 15, 1994

urveyor's Michigan License No. 12020

