

~~SURVEY &~~  
REMONUMENTATION

CHEBOYGAN COUNTY REMONUMENTATION CORNER

MAY 05 1997

LAND CORNER RECORDATION CERTIFICATE

Filing Requirement of Act 74, Mich. P.A. 1970

RECEIVED  
FOR RECORD

For corners in

CHEBOYGAN

(County)

Located In:

Corner Code #

1. Public Land Survey

T 35N R 1W

M-9

T \_\_\_\_\_ R \_\_\_\_\_

T \_\_\_\_\_ R \_\_\_\_\_

T \_\_\_\_\_ R \_\_\_\_\_

2. Property Controlling  
in Section

S \_\_\_\_\_ T \_\_\_\_\_ R \_\_\_\_\_

S \_\_\_\_\_ T \_\_\_\_\_ R \_\_\_\_\_

3. Miscellaneous

S \_\_\_\_\_ T \_\_\_\_\_ R \_\_\_\_\_

Property in Section

S \_\_\_\_\_ T \_\_\_\_\_ R \_\_\_\_\_

4. Lot No. \_\_\_\_\_, Recorded Plat \_\_\_\_\_

5. Private Claims \_\_\_\_\_

I, Ronald Bischer, in a field survey on August 27, 1996,  
do hereby certify that under requirements of P.A. 74, Michigan P.A. of 1970, the corner points mentioned  
in lines 1 and 2 above were in conformance with regulations and rules therefore as required in the current  
manual of survey instructions of the United States Department of the Interior, Bureau of Land  
Management or by a decree of a Court of Law and/or that the corner points mentioned in lines 3, 4 and  
5 above were in conformance with the rules of the Michigan Board of Professional Surveyors or by a  
Decree of a Court of Law; established, re-established, monumented, re-monumented, recovered, found  
as expressed below:

NOTE: Not more than 4 corners, all in the same town and range, may be recorded  
on this certificate.

A. Description of original monument and accessories and/or subsequent restoration:

1840 GLO Survey - John Hodgson

Set Wood Post

Birch 7" N57° E 17 lks

Cedar 19" S32° W 10 lks

1965 Kenneth Ostling #10068

Set DNR Monument

Set two witnesses

B. Description of corner evidence found and/or method applied in restoring or reestablishing corner:

Found DNR Monument Witnesses gone

C. Description of monument for corner and accessories established to perpetuate locating the position of the corner:

DNR Monument


S86° E 21.65' Fence Corner

N21° W 62.77' 4" Birch

N57° E 32.15' 4" Birch

S14° E 62.90' 12" Aspen

	A	B	C	D	E	F	G	H	I	J	K	L
2	6		5		4		3		2		1	
3												
4	7		8		9		10		11		12	
5												
6	18		17		16		15		14		13	
7												
8	19		20		21		22		23		24	
9												
10	30		29		28		27		26		25	
11												
12	31		32		33		34		35		36	
13												

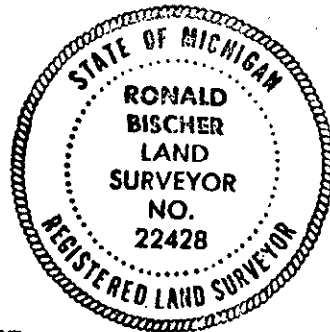

LIBER 010 PAGE 164

Signed by Ronald R Bischer

Date Sept. 18, 1996

Surveyor's Michigan License No. 22428

