

FEB 26 1998

1997 CHEBOYGAN COUNTY, STATE OF MICHIGAN REMONUMENTATION

LAND CORNER RECORDATION CERTIFICATE  
Filing Requirement of Act 74, Mich. P.A. 1970

SECTION

For corners in

CHEBOYGAN  
(County)

Located in:

Corner Code #

1. Public Land Survey

T35NR3W K-3

2. Property Controlling  
in Section

S T R

3. Miscellaneous  
Property in Sec.

S T R

4. Lot No. , Recorded Plat

5. Private Claims

RECEIVED FOR RECORD  
ct 9:08 O'Clock

*Joanne Spray*

CLERK/REGISTER  
CHEBOYGAN COUNTY, MICHIGAN

Register of Deeds Stamp & File Number

I, Ronald Bischer, in a field survey on Oct 1, 1997 do hereby state that under requirements of P.A. 74, Michigan P.A. of 1970, the corner points mentioned in lines 1 and 2 above were in conformance with regulations and rules therefore as required in the current manual of survey instructions of the United States Department of the Interior, Bureau of Land Management or by a decree of a Court of Law and/or that the corner points mentioned in lines 3, 4 and 5 above were in conformance with the rules of the Michigan Board of Land Surveyors or by a Decree of a Court of Law; established, re-established, monumented, recovered, found as expressed below:

NOTE: Not more than 2 corners, all in the same town and range, may be recorded on this certificate.

	A	B	C	D	E	F	G	H	I	J	K	L	M
1													
2	6		5		4		3		2		1		
3													
4	7		8		9		10		11		12		
5													
6	18		17		16		15		14		13		
7													
8	19		20		21		22		23		24		
9													
10	30		29		28		27		26		25		
11													
12	31		32		33		34		35		36		
13													


A. Description of original monument and accessories and/or subsequent restoration:

K-3  
GLO Notes  
Harvey Mellen  
1855 Resurvey  
Set Post  
14" White Oak N27 $\frac{1}{2}$ ° W 10 lks  
8" White Oak N75 $\frac{1}{2}$ ° E 72 lks

1955 Orlando Doyle #7319  
Found Iron and Set three witnesses  
1961 Dean DelaMater #5778  
Found 3/4" Rod and set three witnesses  
1973 Delmer Porter #15410  
found 1/2" Pipe set three witnesses

B. Description of corner evidence found and/or method applied in restoring or reestablishing corner:

K-3  
Found two 1/2" pipes 1" apart one was 2" deep one was 6" deep  
also found all three Doyle witnesses  
also found two DelaMater witnesses  
also found two Porter witnesses  
Replaced pipes with 5/8" rod and Remon cap in Mon.Box

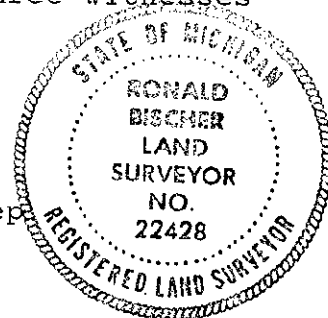


C. Description of monument for corner and accessories established to perpetuate locating the position of the corner:

K-3  
5/8" Rod and Remon cap in Mon. Box

S37° W 69.37' 13" White Oak  
N77° E 38.71' 14" Red Oak  
N42° W 49.88' 18" White Pine  
N75° W 31.42' 13" White Pine  
N40° E 61.48' 18" Red Oak

Doyle Witness  
Doyle Witness  
Doyle witness  
DelaMater witness  
Porter witness

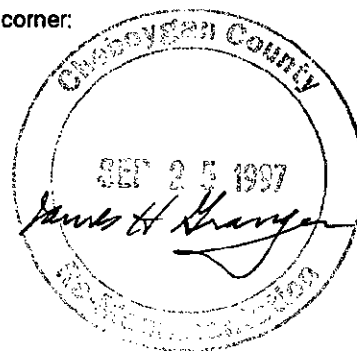

Signed by Ronald R. Bischer  
Surveyor's Michigan License No. 22428

Date Oct. 10, 1997