

1997 CHEBOYGAN COUNTY, STATE OF MICHIGAN REMONUMENTATION

LAND CORNER RECORDATION CERTIFICATE  
Filing Requirement of Act 74, Mich. P.A. 1970

For corners in

CHEBOYGAN  
(County)

Located In:

Corner Code #

1. Public Land Survey

T R  
T R  
T R  
T R

2. Property Controlling  
in Section

S 11 T 35N R 3W

MC 3

3. Miscellaneous  
Property in Sec.

S T R  
S T R

4. Lot No. , Recorded Plat  
5. Private Claims

I, Ronald Bischer, in a field survey on Oct 1, 19 97 do hereby state that under requirements of P.A. 74, Michigan P.A. of 1970, the corner points mentioned in lines 1 and 2 above were in conformance with regulations and rules therefore as required in the current manual of survey instructions of the United States Department of the Interior, Bureau of Land Management or by a decree of a Court of Law and/or that the corner points mentioned in lines 3, 4 and 5 above were in conformance with the rules of the Michigan Board of Land Surveyors or by a Decree of a Court of Law; established, re-established, monumented, recovered, found as expressed below:

NOTE: Not more than 2 corners, all in the same town and range, may be recorded on this certificate.

A. Description of original monument and accessories and/or subsequent restoration:  
MC Between J-5 & K-5

GLO Notes  
Harvey Mellen  
1855 Resurvey  
Set Wood Post  
7" Aspen S03° E 15 lks  
8" Yellow Pine N76° E 24 lks

B. Description of corner evidence found and/or method applied in restoring or reestablishing corner:

MC  
Set 5/8" Rod and Remon Cap at high water line of Burt lake  
in line with Property controlling monuments to the east

C. Description of monument for corner and accessories established to perpetuate locating the position of the corner:

MC  
5/8" Rod and Remon cap  
  
N23° E 37.41' Concrete Monument  
N39° W 17.70' 11" Spruce  
S33° W 21.85' 11" Cedar  
S37° E 25.82' 14" Cedar

LIBER 011 PAGE 50

12-22-97

RECEIVED FOR RECORD

at 9:02 O'Clock A.M

James Spray

CLEK/REGISTER

CHEBOYGAN COUNTY, MICHIGAN



Register of Deeds Stamp & File Number

	A	B	C	D	E	F	G	H	I	J	K	L	M
1													
2	6		5		4		3		2		1		
3													
4	7		8		9		10		11		12		
5													
6	18		17		16		15		14		13		
7													
8	19		20		21		22		23		24		
9													
10	30		29		28		27		26		25		
11													
12	31		32		33		34		35		36		
13													

SURVEY &  
REMONUMENTATION

FEB 26 1998

SECTION

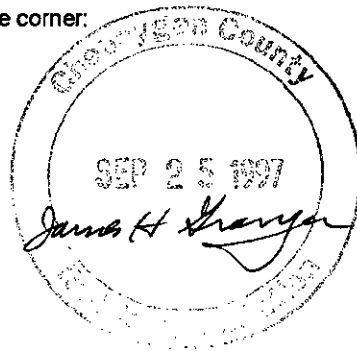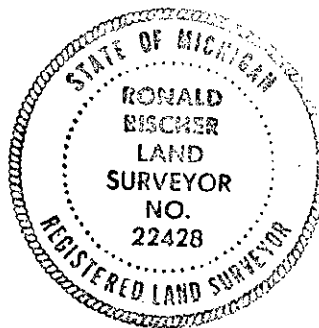

Signed by Ronald R. Bischer  
Surveyor's Michigan License No. 22428

Date Oct. 10, 1997