

LAND CORNER RECORDATION CERTIFICATE
Filing Requirement of Act 74, Mich. P.A. 1970

For corners in

CHEBOYGAN
 (County)

Located In:

Corner Code #

1. Public Land Survey

T	R	
T	R	
T	R	
T	R	
S24	T35N	R3W
S	T	R
S	T	R
S	T	R

2. Property Controlling in Section

3. Miscellaneous Property in Sec.

4. Lot No. _____, Recorded Plat _____

5. Private Claims _____

100-22-97

RECEIVED FOR RECORD
 at 9:04 O'Clock A M
Joanne Spray
 CLERK/REGISTER
 CHEBOYGAN COUNTY, MICHIGAN
 Register of Deeds Stamp & File Number


I, Ronald Bischer, in a field survey on Oct 8, 1997 do hereby state that under requirements of P.A. 74, Michigan P.A. of 1970, the corner points mentioned in lines 1 and 2 above were in conformance with regulations and rules therefore as required in the current manual of survey instructions of the United States Department of the Interior, Bureau of Land Management or by a decree of a Court of Law and/or that the corner points mentioned in lines 3, 4 and 5 above were in conformance with the rules of the Michigan Board of Land Surveyors or by a Decree of a Court of Law; established, re-established, monumented, recovered, found as expressed below:

NOTE: Not more than 2 corners, all in the same town and range, may be recorded on this certificate.

	A	B	C	D	E	F	G	H	I	J	K	L	M
1													
2	6		5		4		3		2		1		
3													
4	7		8		9		10		11		12		
5													
6	18		17		16		15		14		13		
7													
8	19		20		21		22		23		24		
9													
10	30		29		28		27		26		25		
11													
12	31		32		33		34		35		36		
13													

A. Description of original monument and accessories and/or subsequent restoration:

MC Between K-7 and K-8 at Burt Lake
 GLO Notes
 Harvey Mellen
 1855 Resurvey
 8" Cedar for Meander corner
 12" Cedar N26° E 33 lks

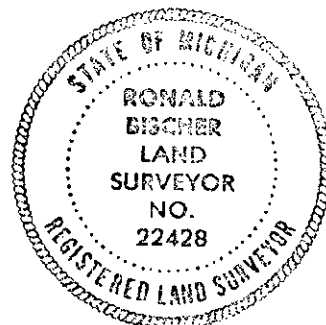

B. Description of corner evidence found and/or method applied in restoring or reestablishing corner:

M.C.
 Set 5/8" Rod and Remon cap
 on original bearing south of Section corner
 at high water line

**SURVEY &
 REMONUMENTATION**

FEB 26 1998


SECTION

C. Description of monument for corner and accessories established to perpetuate locating the position of the corner:

M.C.
 5/8" Rod and Remon cap

North 127.39' Section corner concrete monument
 South 3.94' 14" Spruce
 S59° E 13.21' 14" Spruce
 N87° W 6.43' 11" Cedar
 N33° E 44.81' 11" Lynn

LIBER 011 PAGE 52

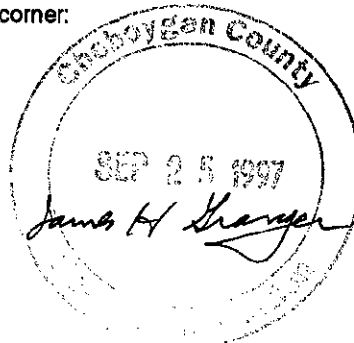Signed by Ronald R. BischerDate Oct. 10, 1997Surveyor's Michigan License No. 22428