

CHEBOYGAN COUNTY
REMONUMENTATION

1998

SECTION

LAND CORNER RECORDATION CERTIFICATE
Filing Requirement of Act 74, Mich. P.A. 1970

For corners in

Cheboygan

(County)

Located In:

Corner Code #

Forest Township

1. Public Land Survey

Waverly Township

T 34N R 1E

T 35N R 1E

T R

T R

S T R

S T R

S T R

S T R

B-1

B-13

RECEIVED FOR RECORD 12-7-98
at 9:27 O'Clock A M

Joanne Spray

CLERK/REGISTER
CHEBOYGAN COUNTY, MICHIGAN

Register of Deeds Stamp & File Number

4. Lot No. , Recorded Plat
5. Private Claims

I, Ronald Bischer, in a field survey on 7-13, 1998 do hereby state that under requirements of P.A. 74, Michigan P.A. of 1970, the corner points mentioned in lines 1 and 2 above were in conformance with regulations and rules therefore as required in the current manual of survey instructions of the United States Department of the Interior, Bureau of Land Management or by a decree of a Court of Law and/or that the corner points mentioned in lines 3, 4 and 5 above were in conformance with the rules of the Michigan Board of Land Surveyors or by a Decree of a Court of Law; established, re-established, monumented, recovered, found as expressed below:


NOTE: Not more than 2 corners, all in the same town and range, may be recorded on this certificate.

A	B	C	D	E	F	G	H	I	J	K	L	M
1												
2	6	5	4	3	2	1						
3												
4	7	8	9	10	11	12						
5												
6	18	17	16	15	14	13						
7												
8	19	20	21	22	23	24						
9												
10	30	29	28	27	26	25						
11												
12	31	32	33	34	35	36						
13												

A. Description of original monument and accessories and/or subsequent restoration:

B-1
1840
John Hodgson
1855 GLO Notes George Cannon (Resurvey)
Set Wood Post
N44°W 41ks 7" Hemlock
N50°E 101ks 6" Hemlock

OCT. 10, 1986 Norman Quaine #33984
Found 1" Pipe

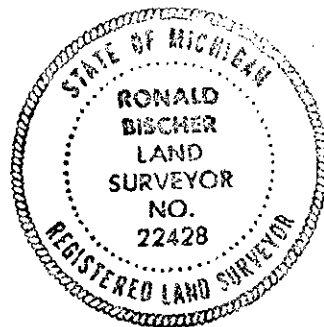

B. Description of corner evidence found and/or method applied in restoring or reestablishing corner:


B-1
Found 1" pipe
no witnesses
replace with 5/8" rod and remon cap

C. Description of monument for corner and accessories established to perpetuate locating the position of the corner:

B-1
5/8" rod and remon cap

S79°W 60.02' 9" Red Pine
S35°E 31.06' 13" White Pine
S67°E 64.92' 15" Red pine
N08°E 27.74' Fence post

LIBER 011 PAGE 92

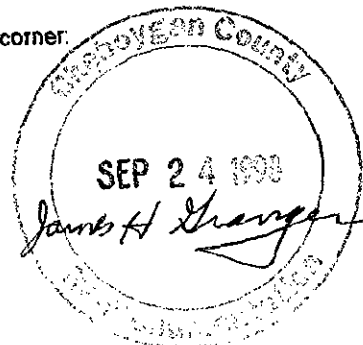

Signed by Ronald R. Bischer
Surveyor's Michigan License No. 22428

Date Sept. 28, 1998