

SEP 7 1999

1998 CHEBOYGAN COUNTY, STATE OF MICHIGAN REMONUMENTATION

LAND CORNER RECORDATION CERTIFICATE
Filing Requirement of Act 74, Mich. P.A. 1970

For corners in

Cheboygan

(County)

Forest Township

1. Public Land Survey
Waverly Township

Located In:

Corner Code #

T34NR 1E

T35NR 1E

T R

T R

C-1

C-13

RECEIVED FOR RECORD 12-7-98
at 9:29 O'Clock A. M

Joanne Spray

CLERK/REGISTER
CHEBOYGAN COUNTY, MICHIGAN

Register of Deeds Stamp & File Number

4. Lot No. , Recorded Plat
5. Private Claims

I, Ronald Bischer, in a field survey on 7-13, 1998 do hereby state that under requirements of P.A. 74, Michigan P.A. of 1970, the corner points mentioned in lines 1 and 2 above were in conformance with regulations and rules therefore as required in the current manual of survey instructions of the United States Department of the Interior, Bureau of Land Management or by a decree of a Court of Law and/or that the corner points mentioned in lines 3, 4 and 5 above were in conformance with the rules of the Michigan Board of Land Surveyors or by a Decree of a Court of Law; established, re-established, monumented, recovered, found as expressed below:

NOTE: Not more than 2 corners, all in the same town and range, may be recorded on this certificate.

	A	B	C	D	E	F	G	H	I	J	K	L	M
1													
2	6		5		4		3		2		1		
3													
4	7		8		9		10		11		12		
5													
6	18		17		16		15		14		13		
7													
8	19		20		21		22		23		24		
9													
10	30		29		28		27		26		25		
11													
12	31		32		33		34		35		36		
13													

A. Description of original monument and accessories and/or subsequent restoration:

C-1

1840 John Hodgson

1855 GLO Notes by George Cannon (Resurvey)
set wood post

S32°E 15 lks 9" Cedar

S50°W 25 lks 8" Cedar

N40°W 10.5 lks 12" Spruce

N52°E 53 lks 10" Spruce

B. Description of corner evidence found and/or method applied in restoring or reestablishing corner:

C-1

Found 3" Pipe

replaced with 5/8" rod and remon cap

June 7, 1972

Delmer Porter #15410

Found 3" Pipe at intersections of road
set 7 witnesses


Oct. 9, 1973 Delmer Porter #15410

found 3" Pipe

found same witnesses

June 23, 1976 Delmer Porter #15410

found 3" Pipe same witnesses as above

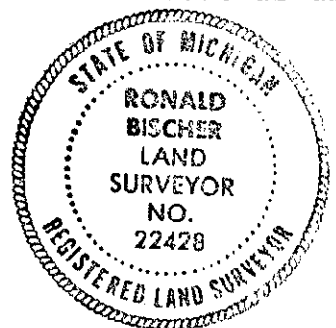

C. Description of monument for corner and accessories established to perpetuate locating the position of the corner:

C-1

5/8" Rod and Remon cap


S54°W 45.41' P. Pole

N39°W 51.88' P. Pole

N52°E 48.38' P. Pole

S45°E 42.97' Fence corner

LIBER 011 PAGE 94

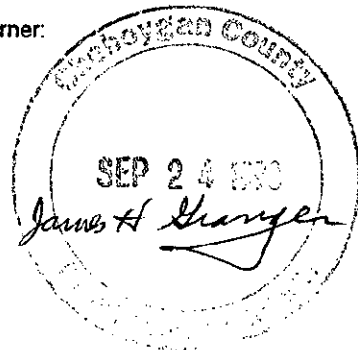

Signed by Ronald R. Bischer

Surveyor's Michigan License No. 22428

Date Sept. 28, 1998