

SEP 28 1999

1998 CHEBOYGAN COUNTY, STATE OF MICHIGAN REMONUMENTATION

LAND CORNER RECORDATION CERTIFICATE
Filing Requirement of Act 74, Mich. P.A. 1970

SECTION

For corners in

Cheboygan

(County)

Located In:

Corner Code #

Forest Township
1. Public Land Survey

Waverly Township

T 34N R 1E

T 35N R 1E

T R

T R

F-1

F-13

2. Property Controlling
in Section

3. Miscellaneous
Property in Sec.

4. Lot No. , Recorded Plat

5. Private Claims

RECEIVED FOR RECORD 12-7-98
at 9:37 O'Clock A M

Joanne Spray

CLERK/REGISTER
CHEBOYGAN COUNTY, MICHIGAN

Register of Deeds Stamp & File Number

I, Ronald Bischer in a field survey on 7-15, 19 98 do hereby state that under requirements of P.A. 74, Michigan P.A. of 1970, the corner points mentioned in lines 1 and 2 above were in conformance with regulations and rules therefore as required in the current manual of survey instructions of the United States Department of the Interior, Bureau of Land Management or by a decree of a Court of Law and/or that the corner points mentioned in lines 3, 4 and 5 above were in conformance with the rules of the Michigan Board of Land Surveyors or by a Decree of a Court of Law; established, re-established, monumented, recovered, found as expressed below:

NOTE: Not more than 2 corners, all in the same town and range, may be recorded on this certificate.

1	A	B	C	D	E	F	G	H	I	J	K	L	M
2		6		5		4		3		2		1	
3													
4		7		8		9		10		11		12	
5													
6		18		17		16		15		14		13	
7													
8		19		20		21		22		23		24	
9													
10		30		29		28		27		26		25	
11													
12		31		32		33		34		35		36	
13													

A. Description of original monument and accessories and/or subsequent restoration:

F-1

1840 John Hodgson

1855 George Cannon (Resurvey)

Set wood post

N42°E 28 lks 15" Y. Pine


N47°W 90 lks 15" Y. pine

Nov. 6, 1964 Orlando Doyle #7319

Found stake replaced with 3/4" Pipe

3 witnesses

June 12, 1978 Ronald Bischer #22428
found 3/4" Pipe and 4x4 stake
3 witnesses

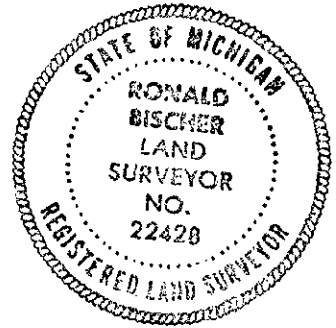

B. Description of corner evidence found and/or method applied in restoring or reestablishing corner:

F-1

found 3/4" pipe and 2 witnesses
replaced with 5/8" rod and remon cap


C. Description of monument for corner and accessories established to perpetuate locating the position of the corner:

F-1

5/8" rod and remon cap

N20°W 48.85' 10" Norway O.W.
S70°W 59.20' 18" Norway O.W.
S33°E 31.73' 9" Norway
N66°E 15.17' 8" Norway

LIBER 011 PAGE 102

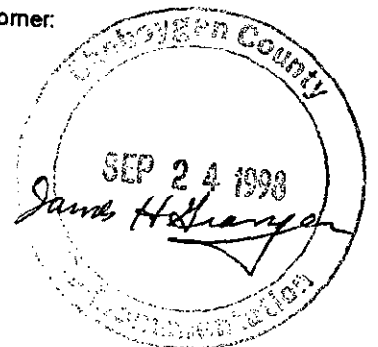

Signed by Ronald E. Bischer

Surveyor's Michigan License No. 22428

Date Sept. 28, 1998