

LAND CORNER RECORDATION CERTIFICATE
Filing Requirement of Act 74, Mich. P.A. 1970

For corners in

Cheboygan (County) Located In: Corner Code #
1. Public Land Survey T 35N R 1E A-11
T 35N R 1E B-11
2. Property Controlling S T R
in Section S T R
3. Miscellaneous S T R
Property in Sec. S T R

Register of Deeds Stamp & File Numb

4. Lot No. , Recorded Plat
5. Private Claims

I, Carl T. Kiiskila, in a field survey on June 30, 19 98 do hereby state that under requirements of P.A. 74, Michigan P.A. of 1970, the corner points mentioned in lines 1 and 2 above were in conformance with regulations and rules therefore as required in the current manual of survey instructions of the United States Department of the Interior, Bureau of Land Management or by a decree of a Court of Law and /or that the corner points mentioned in lines 3, 4 and 5 above were in conformance with the rules of the Michigan Board of Land Surveyors or by a Decree of a Court of Law; established, re-established, monumented, recovered, found as expressed below:

Table with 13 rows and 13 columns (A-M). Contains numerical data for survey points.

NOTE: Not more than 2 corners, all in the same town and range, may be recorded on this certificate.

A. Description of original monument and accessories and/or subsequent restoration:

- A-11 GLO - George Cannon set section post in 1855. Wit: Beech 14" S 70° E 13 links Beech 15" N 50° E 44 links
- B-11 GLO - George Cannon set quarter section post in 1855. Wit: Hemlock 15" S 8° W 26 links Cedar 10" N 55° W 13 links


B. Description of corner evidence found and/or method applied in restoring or reestablishing corner:

- A-11 Found a Cheboygan County remonumentation monument fitting Ronald Bischer's (PS #22428) position and witnesses recorded in Liber 1, page 215 of Cheboygan County Register of Deeds.
- B-11 Found and accepted a 1/2" iron rod of unknown origin for the South quarter corner of Section 30. This position has been used by local surveyors for surveys in the area.

C. Description of monument for corner and accessories established to perpetuate locating the position of the corner:

- A-11 Found Cheboygan County remonumentation monument in a monument box in the centerline of the east-west road and road north. Wit: PK nail in power pole S 50° W 43.49' Northwest corner of old school S 21° E 94.90' Telephone riser N 41° W 43.72' Fence post N 33° E 61.98'
- B-11 Found a 1/2" iron rod in the centerline of the east-west blacktop road and centerline of the gravel road south. Wit: Power pole N 86° E 155.46' Power pole N 41° W 47.53' Set nail in 4" Red Pine S 7° W 38.53' Set nail in 3" Spruce S 26° E 83.90'

Signed by [Signature]
Surveyor's Michigan License No. 33981

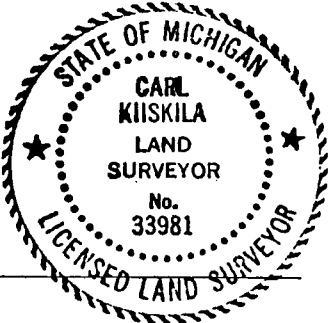

Date 7-28-99