

LAND CORNER RECORDATION CERTIFICATE
Filing Requirement of Act 74, Mich. P.A. 1970

For corners in

<u>Cheboygan</u> (County)	Located In:	Corner Code #
1. Public Land Survey	T <u>35N</u> R <u>1E</u>	<u>A-9</u>
	T <u>35N</u> R <u>1E</u>	<u>A-10</u>
2. Property Controlling in Section	S <u> </u> T <u> </u> R <u> </u>	<u> </u>
	S <u> </u> T <u> </u> R <u> </u>	<u> </u>
3. Miscellaneous Property in Sec.	S <u> </u> T <u> </u> R <u> </u>	<u> </u>
	S <u> </u> T <u> </u> R <u> </u>	<u> </u>

Register of Deeds Stamp & File Num

4. Lot No. , Recorded Plat

5. Private Claims

I, Carl T. Kiiskila, in a field survey on June 30, 19 98 do hereby state that under requirements of P.A. 74, Michigan P.A. of 1970, the corner points mentioned in lines 1 and 2 above were in conformance with regulations and rules therefore as required in the current manual of survey instructions of the United States Department of the Interior, Bureau of Land Management or by a decree of a Court of Law and /or that the corner points mentioned in lines 3, 4 and 5 above were in conformance with the rules of the Michigan Board of Land Surveyors or by a Decree of a Court of Law; established, re-established, monumented, recovered, found as expressed below:

NOTE: Not more than 2 corners, all in the same town and range, may be recorded on this certificate.

	A	B	C	D	E	F	G	H	I	J	K	L	M
1													
2	6		5		4		3		2		1		
3													
4	7		8		9		10		11		12		
5													
6	18		17		16		15		14		13		
7													
8	19		20		21		22		23		24		
9													
10	30		29		28		27		26		25		
11													
12	31		32		33		34		35		36		
13													

A. Description of original monument and accessories and/or subsequent restoration:

A-9 GLO - George Cannon set section post in 1855.
Wit: Cedar 12" S 19° E 24 links
Yellow Birch 10" N 55° E 13 links

A-10 GLO - George Cannon set section post in 1855.
Wit: Hemlock 16" N 68° W 9 links
Balsam 10" S 39° W 12 links

Kenneth J. Ostling in 1965 reestablished this corner by proportionate measurement between section corners.
Set a 1/2" iron bar.

Kenneth J. Ostling in 1965 found an old stake driven in the center of a 5" coil spring at the corner with a fence line west.
Set a standard DNR monument.

B. Description of corner evidence found and/or method applied in restoring or reestablishing corner:

A-9 Found a standard DNR monument fitting K. J. Ostling's witnesses.


A-10 Found a Cheboygan County remonumentation monument fitting K. J. Ostling's position and witnesses reasonably well.

C. Description of monument for corner and accessories established to perpetuate locating the position of the corner:

A-9 Found DNR monument. Set a carsonite marker post.
Wit: Set nail in 4" White Birch N 18° W 62.89'
Set nail in 4" White Birch N 61° E 32.13'
Fence post S 79° E 21.61'
Set nail in 8" Poplar S 11° E 63.03'
Spruce stump S 60° E 78.7' ±
Carsonite post set North 1' ±

A-10 Found a Cheboygan County remonumentation monument 1' ± east of north-south road centerline.
Set carsonite marker post.
Wit: Set nail in 18" Red Pine S17° E 78.21'
Set nail in 9" Red Pine N 35° E 39.50'
Set nail in 6" Red Pine N 77° W 47.08'
Set nail in 10" Spruce S 54° W 58.59'
Carsonite post set West 33' ±

Signed by Carl T Kiiskila
Surveyor's Michigan License No. 33981

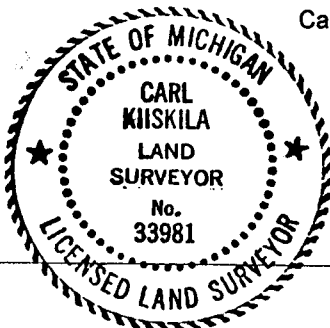

Date 7-28-99