

SURVEY &
REMONUMENTATION

MAY 03 1995

COMMISSION

CHEBOYGAN COUNTY REMONUMENTATION CORNER
LAND CORNER RECORDATION CERTIFICATE
Filing Requirement of Act 74, Mich. P.A. 1970

DEC 29 1994

RECEIVED FOR RECORD
at 12:43 O'Clock P M

J. J. J. J. J.

CLERK/REGISTER
CHEBOYGAN COUNTY, MICHIGAN

Register of Deeds Stamp & File Number

For corners in
CHEBOYGAN
(County)

Located In:

Corner Code =#

1. Public Land Survey	T 36N R 1W	A-10
	T R	
	T R	
	T R	
2. Property Controlling in Section	S T R	
	S T R	
3. Miscellaneous Property in Sec.	S T R	
	S T R	

4. Lot No. , Recorded Plat
5. Private Claims

I, Richard C. Dunn, in a field survey on October, 19 94, do hereby certify that under requirements of P.A. 74, Michigan P.A. of 1970, the corner points mentioned in lines 1 and 2 above were in conformance with regulations and rules therefore as required in the current manual of survey instructions of the United States Department of the Interior, Bureau of Land Management, or by a decree of a Court of Law and/or that the corner points mentioned in lines 3, 4 and 5 above were in conformance with the rules of the Michigan Board of Land Surveyors or by a Decree of a Court of Law; established, re-established, monumented, re-monumented, recovered, found as expressed below:

NOTE: Not more than 4 corners, all in the same town and range, may be recorded on this certificate.

A. Description of original monument and accessories and/or subsequent restoration:


G.L.O. John Mullett 1840
Set Wood Post
12" Aspen N41°E 13 Links
10" Fir S58°W 12 Links

Ron Bischer #22428, 11-11-93
3/4" Pipe
15" Maple N60°E 25.98'
7" Maple N15°W 34.34'
4" Birch S60°W 6.50'

	A	B	C	D	E	F	G	H	I	J	K	L	M
2	6	5	4	3	2	1							
3													
4	7	8	9	10	11	12							
5													
6	18	17	16	15	14	13							
7													
8	19	20	21	22	23	24							
9													
10	30	29	28	27	26	25							
11													
12	31	32	33	34	35	36							
13													

B. Description of corner evidence found and/or method applied in restoring or reestablishing corner:

Fnd. 3/4" Pipe per Ron Bischer survey dated November 11, 1993.

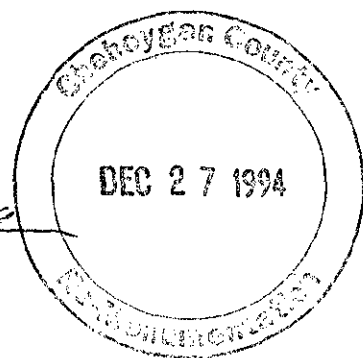

C. Description of monument for corner and accessories established to perpetuate locating the position of the corner:

A-10 Fnd. 3/4" pipe per Ron Bischer survey dated November 11, 1993 and replaced with 5/8" by 30" Iron Bar and 3" aluminum cap and is accepted as a careful and faithful reestablishment of the position of the original corner.
20" Maple N5°E 34.34'
18" Tw. Maple N75°E 25.46'
6" Spruce S77°W 89.56'
3" Maple N53°W 34.15'

LIBER 010 PAGE 91

Signed by *Richard C. Dunn*

Date December 15, 1994

Surveyor's Michigan License No. 12020

