


MICHIGAN  
DEPARTMENT OF CONSERVATION  
FORESTRY DIVISION

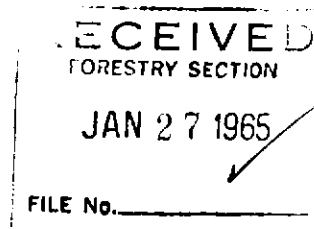

# LAND CORNER RECORD

T. 36 N.R. 1 W.


Cheboygan COUNTY

DESCRIPTION OF CORNER Section corner common to Sections 26 - 27 - 34 - 35

CORNER MONUMENT Set 1" pipe with 4" brass cap

DATE MONUMENT PLACED AND WITNESSED November 13, 1964

WITNESSES TO CORNER.....

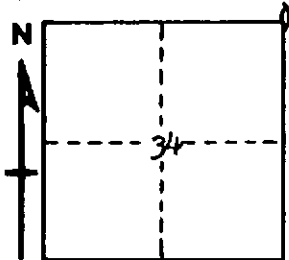

12" W. Pine Stp S 1 E 31.3'

14" W. Pine Stp N 26 E 25.5'

AND

CIRCLE CORNER REGISTERED

## DESCRIPTION IN DETAIL AS TO HOW CORNER WAS LOCATED AND IDENTIFIED OR RESTORED.

This corner was found while making a survey to this area. Located old stake point from NW U.S.B.T. stump which is in place with part of face and notch. Remains of 1E BT in place. An old corner, 1" axle shaft is N 77 E 20.5', but obviously was not set in accordance with the U. S. record.

SURVEYOR'S SEAL

SIGNED

*Kenneth J. Osting*  
REGISTERED LAND SURVEYOR #10068

DATE January 20, 1965