

SURVEY &
REMONUMENTATION

Benton

1993

105

COMMISSION

CHEBOYGAN COUNTY REMONUMENTATION CORNER
LAND CORNER RECORDATION CERTIFICATE

Filing Requirement of Act 74, Mich. P.A. 1970

For corners in

CHEBOYGAN
(County)

Located In:

Corner Code ##

1. Public Land Survey T 37N R 1E A-5
T _____ R _____
T _____ R _____
T _____ R _____
2. Property Controlling S _____ T _____ R _____
in Section S _____ T _____ R _____
3. Miscellaneous S _____ T _____ R _____
Property in Sec. S _____ T _____ R _____

4. Lot No. _____, Recorded Plat _____
5. Private Claims _____

I, Ronald R. Bischer, in a field survey on September 22, 19 93, do hereby certify that under requirements of P.A. 74, Michigan P.A. of 1970, the corner points mentioned in lines 1 and 2 above were in conformance with regulations and rules therefore as required in the current manual of survey instructions of the United States Department of the Interior, Bureau of Land Management or by a decree of a Court of Law and/or that the corner points mentioned in lines 3, 4 and 5 above were in conformance with the rules of the Michigan Board of Land Surveyors or by a Decree of a Court of Law; established, re-established, monumented, re-monumented, recovered, found as expressed below:

NOTE: Not more than 4 corners, all in the same town and range, may be recorded on this certificate.

A. Description of original monument and accessories and/or subsequent restoration:

A-5
Original Survey - June 1840
John Hodgson set Wood Post
7" Pine S42°E 7½ links
10" Black Oak N73°W 18 links
1963 - Kenneth Ostling
Set Conservation Monument
7" J. Pine N15°W 19.6'
7" R. Pine S68°W 31.1'
8" R. Pine S15°E 20.2'
1964 - Kenneth Larsen
Conservation Monument
witnesses same as above

B. Description of corner evidence found and/or method applied in restoring or reestablishing corner:

A-5
Conservation Dept. Monument
N15°W 19.89' 9" Jack Pine
S68°W 31.10' 7" Red Oak
appears to be same witness from Ostling
referred to as 7" R. Pine
S15°E 20.64' 16" R. Pine

C. Description of monument for corner and accessories established to perpetuate locating the position of the corner:

A-5
Conservation Department Monument
N15°W 19.89' 9" Jack Pine
S68°W 31.10' 7" Red Oak
S15°E 20.64' 16" Red Pine
S88°E 19.84' 7" White Pine

Set nail with witness tag #22428 in witnesses.



RECEIVED
FOR RECORD

93 DEC 22 AM 10:08

James H. Gray
CLERK/REGISTER
CHEBOYGAN COUNTY, MICHIGAN

Register of Deeds Stamp & File Number

	A	B	C	D	E	F	G	H	I	J	K	L	M
2	6		5		4		3		2		1		
3													
4	7		8		9		10		11		12		
5													
6	18		17		16		15		14		13		
7													
8	19		20		21		22		23		24		
9													
10	30		29		28		27		26		25		
11													
12	31		32		33		34		35		36		
13													

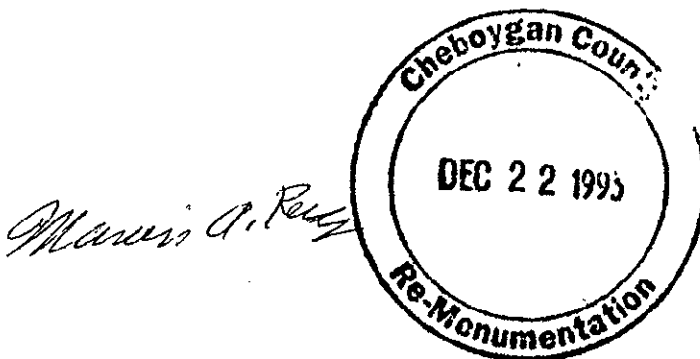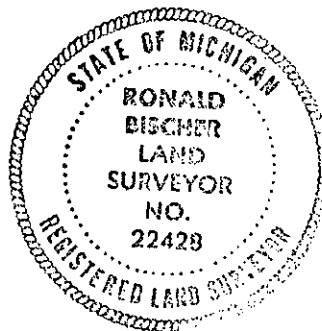

LIBER 010 PAGE 18

Signed by Ronald R. Bischer Date 12-03-93
Surveyor's Michigan License No. 22428