

SURVEY & REMONUMENTATION

CHEBOYGAN COUNTY REMONUMENTATION CORNER

RECEIVED
FOR RECORD

MAY 03 1995

LAND CORNER RECORDATION CERTIFICATE
Filing Requirement of Act 74, Mich. P.A. 1970

NOV 22 AM 10:21

For corners in

CHEBOYGAN COMMISSION
(County)

Located In:

Corner Code #

James H. Granger
CLERK/REGISTER
CHEBOYGAN COUNTY, MICHIGAN

1. Public Land Survey T 37N R 1W A-4
T _____ R _____
T _____ R _____
T _____ R _____
2. Property Controlling S _____ T _____ R _____
in Section S _____ T _____ R _____
3. Miscellaneous S _____ T _____ R _____
Property in Sec. S _____ T _____ R _____

Register of Deeds Stamp & File Number

4. Lot No. _____ Recorded Plat _____
5. Private Claims _____

	A	B	C	D	E	F	G	H	I	J	K	L	M
2	6	5	4	3	2	1							
3													
4	7	8	9	10	11	12							
5													
6	18	17	16	15	14	13							
7													
8	19	20	21	22	23	24							
9													
10	30	29	28	27	26	25							
11													
12	31	32	33	34	35	36							
13													

I, Ronald Bischer, in a field survey on July 6, 19 94, do hereby certify that under requirements of P.A. 74, Michigan P.A. of 1970, the corner points mentioned in lines 1 and 2 above were in conformance with regulations and rules therefore as required in the current manual of survey instructions of the United States Department of the Interior, Bureau of Land Management or by a decree of a Court of Law and/or that the corner points mentioned in lines 3, 4 and 5 above were in conformance with the rules of the Michigan Board of Land Surveyors or by a Decree of a Court of Law; established, re-established, monumented, re-monumented, recovered, found as expressed below:


NOTE: Not more than 4 corners, all in the same town and range, may be recorded on this certificate.

A. Description of original monument and accessories and/or subsequent restoration:

June 1840 GLO Survey - John Mullett 01-03-76 - Delmar E. Porter
Set Wood Post Found 1" Rod in Monument Box
Maple 12" N20°W 36 links N49°W 69.75' Tele. pole
Birch 10" S50°E 8 links N69°E 59.82' 11" Ash
April 1957 - Orlando Doyle S46°30'W 77.10' Cor. conc.
Found 1½" Pipe foundation
S46°30'W 77.10' Cor. Conc. Found. 05-01-88 - James H. Granger
N15°W 98.62' 24" Poplar Found 3/4" Iron in Mon. Box
S30°W 73.58' 6" Ash S41°E 56.73' MBT Post

S56°W 70.58' Stump
N34°W 56.18' Conc. Mon.
N74°E 60.26' 14" Maple

07-15-91 - James H. Granger
same as above

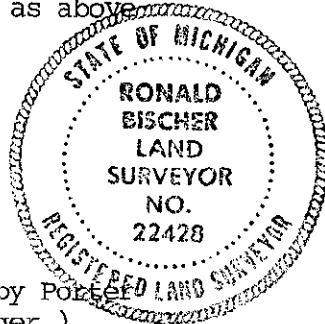

B. Description of corner evidence found and/or method applied in restoring or reestablishing corner:

3/4" Iron in Monument Box
N69°E 59.95' 18" Box Elder (Same witness referred to as 11" Ash in 1976 by Porter and referred to as 14" Maple in 1988 by Granger.)
S56°W 70.58' Stump
N34°W 56.18' Concrete monument
S46°30'W 77.10' Corner concrete foundation of house.


Replaced 3/4" Iron with Cheboygan County Remonumentation Monument in Monument Box.

C. Description of monument for corner and accessories established to perpetuate locating the position of the corner:

Cheboygan County Remonumentation Monument in Monument Box
N69°E 59.95' 18" Box Elder
S56°W 70.58' Stump
N34°W 56.18' Concrete monument
S46°30'W 77.10' Corner concrete foundation of house.

LIBER 010 PAGE 70

Monumental

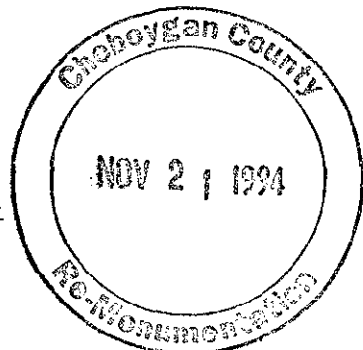

igned by Ronald R. Bischer

Date Oct. 25, 1994

urveyor's Michigan License No. 22428