

SURVEY &  
REMONUMENTATION

CHEBOYGAN COUNTY REMONUMENTATION CORNER

LAND CORNER RECORDATION CERTIFICATE

Filing Requirement of Act 74, Mich. P.A. 1970

MAY 03 1995

RECEIVED  
FOR RECORD

94 NOV 22 AM 10:23

*James Spray*  
CLERK/REGISTER  
CHEBOYGAN COUNTY, MICHIGAN

For corners in

CHEBOYGAN  
(County)

COMMISSION

Located In:

Corner Code ##

- |                                    |            |     |
|------------------------------------|------------|-----|
| 1. Public Land Survey              | T 37N R 1W | A-6 |
|                                    | T R        |     |
|                                    | T R        |     |
|                                    | T R        |     |
|                                    | T R        |     |
| 2. Property Controlling in Section | S T R      |     |
|                                    | S T R      |     |
| 3. Miscellaneous Property in Sec.  | S T R      |     |
|                                    | S T R      |     |

Register of Deeds Stamp & File Number

4. Lot No. \_\_\_\_\_, Recorded Plat \_\_\_\_\_
5. Private Claims \_\_\_\_\_

	A	B	C	D	E	F	G	H	I	J	K	L	M
2	6	5	4	3	2	1							
3													
4	7	8	9	10	11	12							
5													
6	18	17	16	15	14	13							
7													
8	19	20	21	22	23	24							
9													
10	30	29	28	27	26	25							
11													
12	31	32	33	34	35	36							
13													

I, Ronald Bischer, in a field survey on July 6, 19 94, do hereby certify that under requirements of P.A. 74, Michigan P.A. of 1970, the corner points mentioned in lines 1 and 2 above were in conformance with regulations and rules therefore as required in the current manual of survey instructions of the United States Department of the Interior, Bureau of Land Management or by a decree of a Court of Law and/or that the corner points mentioned in lines 3, 4 and 5 above were in conformance with the rules of the Michigan Board of Land Surveyors or by a Decree of a Court of Law; established, re-established, monumented, re-monumented, recovered, found as expressed below:

NOTE: Not more than 4 corners, all in the same town and range, may be recorded on this certificate.

A. Description of original monument and accessories and/or subsequent restoration:

June 1840 GLO Survey - John Mullett  
Set Wood Post  
Cedar 12" N35°E 18 links  
B. Ash 8" S50°W 10 links

July 1962 - Matt Koivisto (MSHD)  
Set 1" Axle from witnesses  
N88°W 32.81' Cor. fence post  
N30°E 57.01' Fence post  
N88°E 32.18' Cor. fence post

January 1964 - Kenneth R. Larsen  
1" Axle  
N88°W 32.81' Cor. fence post  
N30°E 57.01' Fence post  
N88°E 32.18' Cor. fence post

B. Description of corner evidence found and/or method applied in restoring or reestablishing corner:

3/4" Bar in Monument Box  
Found three fence posts with MDOT witness tags  
S46°W 55.36' Fence post  
S83°W 40.75' Fence post  
N46°E 57.94' Fence post

Replaced 3/4" Bar with Cheboygan County Remonumentation Monument in Monument Box




C. Description of monument for corner and accessories established to perpetuate locating the position of the corner:

Cheboygan County Remonumentation Monument in Monument Box

S46°E 57.94' Fence post  
S83°W 40.75' Fence post  
S46°W 55.36' Fence post  
S87°E 40.00' 3/4" Rod w/cap #16051

LIBER 010 PAGE 72

*Marvin A. Ross*

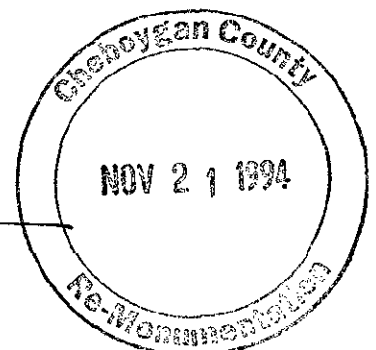

igned by Ronald R. Bischer

Date Oct 25, 1994

urveyor's Michigan License No. 22428