

SURVEY &
REMONUMENTATION

CHEBOYGAN COUNTY REMONUMENTATION CORNER
LAND CORNER RECORDATION CERTIFICATE
Filing Requirement of Act 74, Mich. P.A. 1970

MAY 03 1995

RECEIVED
FOR RECORD

94 NOV 22 AM 10:25

For corners in

CHEBOYGAN
(County) COMMISSION

Located In:

Corner Code --#

James H. Granger
CLERK/REGISTER
CHEBOYGAN COUNTY, MICHIGAN

- | | | | | | |
|-------------------------|---|------------|---|-----------|------------|
| 1. Public Land Survey | T | <u>37N</u> | R | <u>1W</u> | <u>A-8</u> |
| | T | _____ | R | _____ | _____ |
| | T | _____ | R | _____ | _____ |
| | T | _____ | R | _____ | _____ |
| 2. Property Controlling | S | _____ | T | _____ | _____ |
| in Section | S | _____ | T | _____ | _____ |
| 3. Miscellaneous | S | _____ | T | _____ | _____ |
| Property in Sec. | S | _____ | T | _____ | _____ |

Register of Deeds Stamp & File Number

4. Lot No. _____, Recorded Plat _____
5. Private Claims _____

	A	B	C	D	E	F	G	H	I	J	K	L	M
2	6		5		4		3		2		1		
3													
4	7		8		9		10		11		12		
5													
6	18		17		16		15		14		13		
7													
8	19		20		21		22		23		24		
9													
10	30		29		28		27		26		25		
11													
12	31		32		33		34		35		36		
13													

I, Ronald Bischer, in a field survey on July 6, 1994,
do hereby certify that under requirements of P.A. 74, Michigan P.A. of 1970, the corner points mentioned
in lines 1 and 2 above were in conformance with regulations and rules therefore as required in the
current manual of survey instructions of the United States Department of the Interior, Bureau of Land
Management or by a decree of a Court of Law and/or that the corner points mentioned in lines 3, 4 and 5
above were in conformance with the rules of the Michigan Board of Land Surveyors or by a Decree of a
Court of Law; established, re-established, monumented, re-monumented, recovered, found as
expressed below:

**NOTE: Not more than 4 corners, all in the same town and range, may be recorded
on this certificate.**


A. Description of original monument and accessories and/or subsequent restoration:

June 1840 GLO Survey - John Mullett	N15°W 112.22'	Power pole	N15°W 112.22'	Power pole
Set Wood Post	S28°E 65.70'	Power pole	05-01-88 - James H. Granger	
Spruce 12" N55°W 10 links	N78°E 32.64'	3" Apple	N80°E 45.11'	12" Poplar
Cedar 10" S29°E 20 links	January 1964 - Kenneth R. Larsen		S18°E 56.56'	Power pole
October 1946 - Orlando Doyle	same as above		S60°W 30.88'	Power pole
Fd. stake pt., replaced w/3/4" Pipe	02-17-88 - James H. Granger		N86°W 29.65'	14" W. Pine
S45°30'E 39.80' Bell pole	Found Hex Bolt in Mon. Box			
S86°E 24.78' Cor. fence post	N78°E 32.64'	3" Apple		
July 1962 - M.A. Koivisto	N88°W 64.86'	8" Pine		
Fd. 1" "T" Iron	N49°E 32.28'	Fence post		

B. Description of corner evidence found and/or method applied in restoring or reestablishing corner:


Hex Bolt in Monument Box
N11°W 112.60' Power pole
S67°W 64.86' 10" Scotch pine
S78°E 37.46' 4" Apple tree (Tag #15410)

Replaced Hex Bolt with Cheboygan County Remonumentation Monument in Monument Box

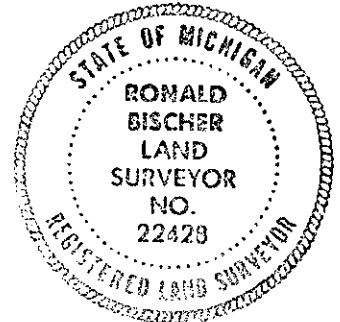

LIBER 010 PAGE 74

Monument A. Larsen

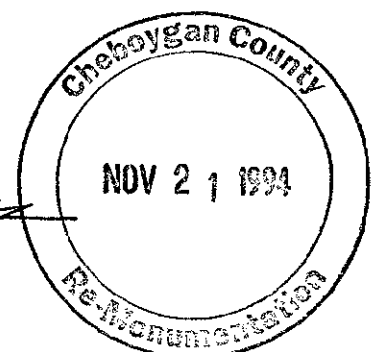

Signed by Ronald R. Bischer
Surveyor's Michigan License No. 22428

Date Oct. 25, 1994