

**SURVEY & REMONUMENTATION**  
**CHEBOYGAN COUNTY REMONUMENTATION CORNER**

MAY 05 1997

**LAND CORNER RECORDATION CERTIFICATE**  
**Filing Requirement of Act 74, Mich. P.A. 1970**

corners in  
HEBOYGAN

**COMMISSION**

(County)

Located In:

Corner Code #

Public Land Survey

T 37N R 3W

M-2

Property Controlling  
in Section

S T R

Miscellaneous

S T R

Property in Sec.

S T R

RECEIVED  
FOR RECORD

96 OCT 30 PM 12:25

*Joanna Spray*

CLERK/REGISTER  
CHEBOYGAN COUNTY, MICHIGAN  
Register of Deeds Stamp & File Number

Lot No. , Recorded Plat

Private Claims

**AMES H. GRANGER**, in a field survey on **SEPTEMBER 24, 19 96**  
hereby state that under requirements of P.A. 74, Michigan P.A. of 1970, the corner points  
mentioned in lines 1 and 2 above were in conformance with regulations and rules therefore as  
laid in the current manual of survey instructions of the United States Department of the Interior,  
Bureau of Land Management or by a decree of a Court of Law and /or that the corner points  
mentioned in lines 3, 4 and 5 above were in conformance with the rules of the Michigan Board of  
Surveyors or by a Decree of a Court of Law; established, re-established, monumented,  
reverted, found as expressed below:

**NOTE:** Not more than 2 corners, all in the same town and range, may be recorded  
on this certificate.

|    | A  | B | C  | D | E  | F | G  | H | I  | J | K  | L | M |
|----|----|---|----|---|----|---|----|---|----|---|----|---|---|
| 1  |    |   |    |   |    |   |    |   |    |   |    |   |   |
| 2  | 6  |   | 5  |   | 4  |   | 3  |   | 2  |   | 1  |   |   |
| 3  |    |   |    |   |    |   |    |   |    |   |    |   |   |
| 4  | 7  |   | 8  |   | 9  |   | 10 |   | 11 |   | 12 |   |   |
| 5  |    |   |    |   |    |   |    |   |    |   |    |   |   |
| 6  | 18 |   | 17 |   | 16 |   | 15 |   | 14 |   | 13 |   |   |
| 7  |    |   |    |   |    |   |    |   |    |   |    |   |   |
| 8  | 19 |   | 20 |   | 21 |   | 22 |   | 23 |   | 24 |   |   |
| 9  |    |   |    |   |    |   |    |   |    |   |    |   |   |
| 10 | 30 |   | 29 |   | 28 |   | 27 |   | 26 |   | 25 |   |   |
| 11 |    |   |    |   |    |   |    |   |    |   |    |   |   |
| 12 | 31 |   | 32 |   | 33 |   | 34 |   | 35 |   | 36 |   |   |
| 13 |    |   |    |   |    |   |    |   |    |   |    |   |   |

Description of original monument and accessories and/or subsequent restoration:


1840 Original Survey Set wood post 12" Cedar S17°W 10 lks  
John Mullett 12" Cedar N20°E 9 lks

1994 LCRC 1" pipe  
Norman Quaine #33984

Description of corner evidence found and/or method applied in restoring or reestablishing corner:

Found 1" pipe and four witnesses


*Monument*

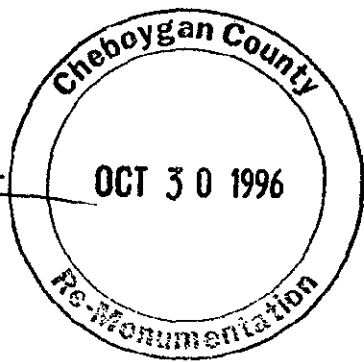

LIBER 010 PAGE 181

Description of monument for corner and accessories established to perpetuate locating the position of the corner:  
**also A-2 T37N, R2W**

1/2" x 5/8" x 30" rebar with Remonumentation Cap  
Pipe  
" Cedar S77°E 15.13' Fd tag  
" Cedar S51°W 21.16' Fd tag  
" Cedar N76°W 15.61' Fd tag  
" Cedar N23°E 10.08' Fd tag

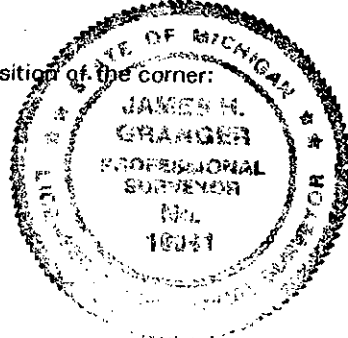

by *James H. Granger*  
Surveyor's Michigan License No. 16041

Date 10-10-96