

# SURVEY & REMONUMENTATION

## CHEBOYGAN COUNTY REMONUMENTATION CORNER

### LAND CORNER RECORDATION CERTIFICATE Filing Requirement of Act 74, Mich. P.A. 1970

MAY 05 1997

For corners in  
CHEBOYGAN COMMISSION

(County)

Located In:

Corner Code #

1. Public Land Survey

T 37N R 3W

M-5

2. Property Controlling  
in Section

S T R

3. Miscellaneous  
Property in Sec.

S T R

4. Lot No. , Recorded Plat

5. Private Claims

RECEIVED  
FOR RECORD

96 OCT 30 PM 12:28

*James H. Granger*

CLERK/REGISTER  
CHEBOYGAN COUNTY, MICHIGAN

Register of Deeds Stamp & File Number

	A	B	C	D	E	F	G	H	I	J	K	L	M
1													
2	6		5		4		3		2		1		
3													
4	7		8		9		10		11		12		
5													
6	16		17		18		19		20		21		
7													
8	19		20		21		22		23		24		
9													
10	30		29		28		27		26		25		
11													
12	31		32		33		34		35		36		
13													

I, JAMES H. GRANGER, in a field survey on SEPTEMBER 24, 19 96  
do hereby state that under requirements of P.A. 74, Michigan P.A. of 1970, the corner points  
mentioned in lines 1 and 2 above were in conformance with regulations and rules therefore as  
required in the current manual of survey instructions of the United States Department of the Interior,  
Bureau of Land Management or by a decree of a Court of Law and/or that the corner points  
mentioned in lines 3, 4 and 5 above were in conformance with the rules of the Michigan Board of  
Land Surveyors or by a Decree of a Court of Law; established, re-established, monumented,  
recovered, found as expressed below:

NOTE: Not more than 2 corners, all in the same town and range, may be recorded  
on this certificate.

A. Description of original monument and accessories and/or subsequent restoration:

1840 Original Survey Set wood post 16" Sugar N55°W 11 lks  
John Mullett 6" Beech S45°E 35 lks

1960 MSHD - LCRC 1/2" bar & broken glass  
Dean Delemater


1980 Survey Found 1/2" bar & broken glass  
Orlando Doyle # 7319

1991 LCRC Found 1/2" bar & broken glass  
Norman Quaine #33984 Raised w/1/2" rod & cap # 15410

B. Description of corner evidence found and/or method applied in restoring or reestablishing corner:

Found 1/2" rod w/ cap # 15410 and three witnesses.

*Monica Rose*

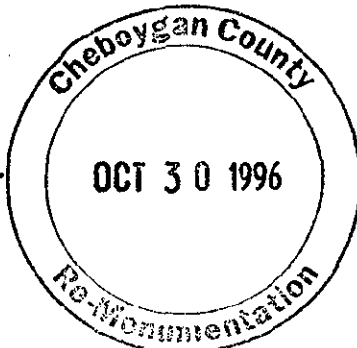


LIBER 010 PAGE 184

C. Description of monument for corner and accessories established to perpetuate locating the position of the corner:  
also corner A-5, T37N, R2W

Set 5/8" x 30" rebar with Remonumentation Cap

1/2" Rod  
Power Pole S41°E 43.62' Fd tag  
Anchor Pole S64°E 84.85' Fd tag  
Anchor Pole N54°E 44.05' Fd tag  
10" Birch N56°W 44.80' Set nail w/tag

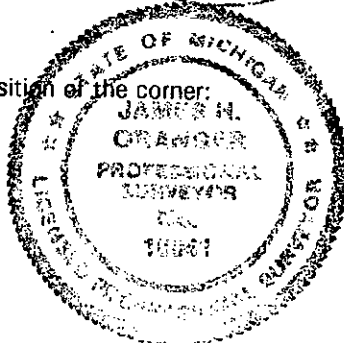

igned by *James H. Granger*  
urveyor's Michigan License No. 16041

Date 10-10-96