

SURVEY & REMONUMENTATION

CHEBOYGAN COUNTY REMONUMENTATION CORNER

MAY 05 1997

LAND CORNER RECORDATION CERTIFICATE Filing Requirement of Act 74, Mich. P.A. 1970

For corners in

CHEBOYGAN
(County)

COMMISSION

Located In:

Corner Code #

RECEIVED
FOR RECORD

96 OCT -1 PM 3:59

Joanna Spray

CLERK/REGISTER
CHEBOYGAN COUNTY, MICHIGAN

Register of Deeds Stamp & File Number

- Public Land Survey T 37N R 2W C-11
T R
T R
T R
- Property Controlling S T R
in Section S T R
- Miscellaneous S T R
Property in Section S T R
- Lot No. , Recorded Plat
- Private Claims

I, Ronald Bischer, in a field survey on September 3, 19 96, do hereby certify that under requirements of P.A. 74, Michigan P.A. of 1970, the corner points mentioned in lines 1 and 2 above were in conformance with regulations and rules therefore as required in the current manual of survey instructions of the United States Department of the Interior, Bureau of Land Management or by a decree of a Court of Law and/or that the corner points mentioned in lines 3, 4 and 5 above were in conformance with the rules of the Michigan Board of Professional Surveyors or by a Decree of a Court of Law; established, re-established, monumented, re-monumented, recovered, found as expressed below:

NOTE: Not more than 4 corners, all in the same town and range, may be recorded on this certificate.

A. Description of original monument and accessories and/or subsequent restoration:

1855 Resurvey - Harvey Mellen
Set Wood Post
Elm 36" S10° W 11 lks
Beech 12" N13° E 36 lks

1973 Orlando Doyle #7319
Found 1" bar
Set three witnesses

B. Description of corner evidence found and/or method applied in restoring or reestablishing corner:

Found 1" Bar in Monument box and one Doyle witness

Replace with Cheboygan County Remonumentation Monument

C. Description of monument for corner and accessories established to perpetuate locating the position of the corner:

Cheboygan County Remonumentation Monument

N48° W 55.12' Fence corner
N35° E 71.31' Utility Pole
S42° E 46.24' 32" Maple
S34° W 60.45' Utility Pole



LIBER 010 PAGE 149

Signed by Ronald R. Bischer

Date Sept 18, 1996

Surveyor's Michigan License No. 22428

	A	B	C	D	E	F	G	H	I	J	K	L
2	6		5		4		3		2		1	
3												
4	7		8		9		10		11		12	
5												
6	18		17		16		15		14		13	
7												
8	19		20		21		22		23		24	
9												
10	30		29		28		27		26		25	
11												
12	31		32		33		34		35		36	
13												

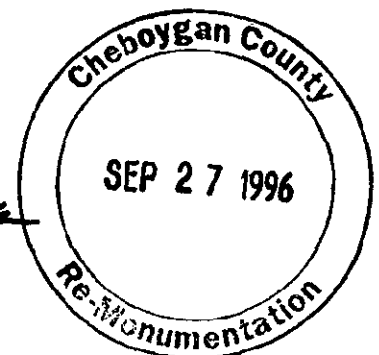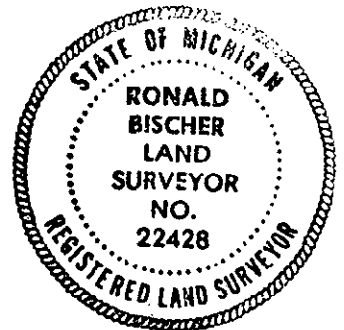

Martin A. Rose