

Benton 1993
COMMISSION

CHEBOYGAN COUNTY REMONUMENTATION CORNER
LAND CORNER RECORDATION CERTIFICATE
Filing Requirement of Act 74, Mich. P.A. 1970

For corners in

CHEBOYGAN
(County)

Located In:

Corner Code ##

1. Public Land Survey

T 38N R 1E

T R

T R

T R

2. Property Controlling
in Section

S 30 T 38N R 1E

S T R

3. Miscellaneous
Property in Sec.

S T R

S T R

Other #1

M.C. North of
A-10 on West
line.

4. Lot No. , Recorded Plat

5. Private Claims

RECEIVED
FOR RECORD

93 DEC 22 AM 9:46

James Spray

CLERK/REGISTER
CHEBOYGAN COUNTY, MICHIGAN

Register of Deeds Stamp & File Number

I, Ronald R. Bischer, in a field survey on September 24, 19 93,
do hereby certify that under requirements of P.A. 74, Michigan P.A. of 1970, the corner points mentioned
in lines 1 and 2 above were in conformance with regulations and rules therefore as required in the
current manual of survey instructions of the United States Department of the Interior, Bureau of Land
Management or by a decree of a Court of Law and/or that the corner points mentioned in lines 3, 4 and 5
above were in conformance with the rules of the Michigan Board of Land Surveyors or by a Decree of a
Court of Law; established, re-established, monumented, re-monumented, recovered, found as
expressed below:

NOTE: Not more than 4 corners, all in the same town and range, may be recorded
on this certificate.

A. Description of original monument and accessories and/or subsequent restoration:

M.C. at intersection of West line of Section 30 and Lake Huron
Set by John Hodgson June 21, 1840 (Wood Post)
8" Pine S05°W 83 links
7" Pine S36½°E 1.00 chain
Original location was 594 feet North of 14 link stream.
No further restoration recorded.


B. Description of corner evidence found and/or method applied in restoring or reestablishing corner:

M.C. at intersection of West line of Section 30 and Lake Huron
Found no evidence of restoration.

Set Cheboygan County Remonumentation Monument by Single Proportion.

Location fits stream measurement from original notes.

	A	B	C	D	E	F	G	H	I	J	K	L	M
2	6		5		4		3		2		1		
3													
4	7		8		9		10		11		12		
5													
6	18		17		16		15		14		13		
7													
8	19		20		21		22		23		24		
9													
10	30		29		28		27		26		25		
11													
12	31		32		33		34		35		36		
13													

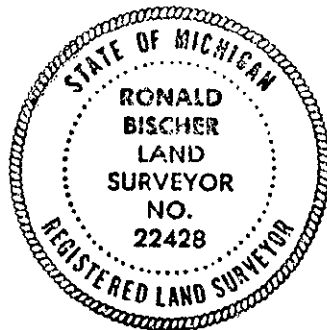


LIGER 010 PAGE 15

C. Description of monument for corner and accessories established to perpetuate locating the position of the corner:

M.C. at intersection of West line of Section 30 and Lake Huron
Cheboygan County Remonumentation Monument
S30°W 2.74' 4" Spruce
S44°E 5.90' 8" Cedar
N27°W 23.77' 9" White Pine
N06°E 20.35' 16" White Pine

Set nail with witness tag #22428 in witnesses.

Marcus A. Ross

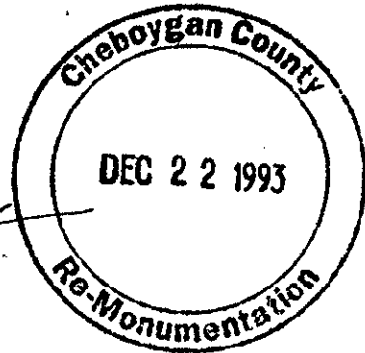

Signed by Ronald R. Bischer

Date 12-3-93

Surveyor's Michigan License No. 22428