

LAND CORNER RECORDATION CERTIFICATE

Filing Requirement of Act 74, Mich. PA 1970

For Corners In:
CHEBOYGAN
(County)

Located In

Corner Code #

1. Public Land Survey	T	38N	R	02W	A-5
	T	38N	R	03W	M-5
2. Property Controlling in Section	S	T	R		
	S	T	R		
3. Miscellaneous Property in Section	S	T	R		
	S	T	R		


Register of Deeds Stamp & File Number

4. Lot No: Recorded Plat:

5. Private Claims:

I, Carl T. Kiiskila, in a field survey on January 26, 2011 do hereby state that under requirements of PA 74, Michigan PA of 1970, the corner points mentioned in lines 1 and 2 above were in conformance with regulations and rules therefore as required in the current manual of survey instructions of the United States Department of the Interior, Bureau of Land Management or by a decree of a Court of Law and/or that the corner points mentioned in lines 3, 4 and 5 above were in conformance with the rules of the Michigan Board of Land Surveyors or by a Decree of a Court of Law; established, re-established, monumented, recovered, found as expressed below:

NOTE: Not more than 2 corners, all in the same town and range, may be recorded on this certificate.

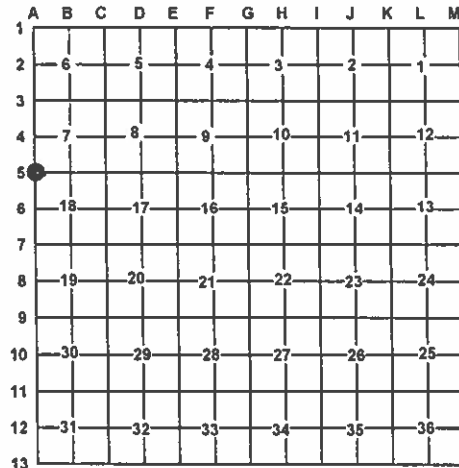

A. Description of original monument and accessories and/or subsequent restoration:

A-5— Sec. cor. comm. to sec.'s 7 & 18, T38N, R02W & sec.'s 12 & 13, T38N, R03W

1996 — Remon L.C.R.C. — L.010, p.172 — James H. Granger,
P.S.#16041 — Found DNR monument with brass cap.
12" Poplar S54°E 79.37' Set nail w/tag
12" Poplar S20°E 53.42' Set nail w/tag
4" Birch S20°W 60.28' Set nail w/tag
6" Birch S49°W 77.31' Set nail w/tag

B. Description of corner evidence found and/or method applies in restoring or re-establishing corner:

A-5— Sec. cor. comm. to sec.'s 7 & 18, T38N, R02W & sec.'s 12 & 13, T38N, R03W

Found 1" dia. galvanized pipe with no cap. Top of pipe was damaged. Replaced found 1" pipe with standard DNR monument. Corner falls 22' North of E-W centerline gravel road in tag alder swamp. Accepted found pipe as a careful and faithful reestablishment of the position of the original corner. Found no other evidence to dispute the location for the corner.

C. Description of monument for corner and accessories established to perpetuate locating the position of the corner:

A-5— Sec. cor. comm. to sec.'s 7 & 18, T38N, R02W & sec.'s 12 & 13, T38N, R03W

4" dia. stamped alum. cap on 1"x 3' Galvanized pipe

Wit: N28°E 16.65' to set N&T on SE side 4" Aspen
N80°E 32.97' to set N&T at fd. N&T#15410 on N side 11" Aspen
S46°E 119.79' to set N&T at fd. N&T#15410 on SW side 11" Cedar
N80°W 111.23' to set N&T at fd. N&T#15410 on S side 8" B. Fir
Set Blue Carsonite Post 1' North



Carl T Kiiskila

3-9-11

Surveyor's Michigan License No.: 33981