

# REMONUMENTATION

## CHEBOYGAN COUNTY REMONUMENTATION CORNER

MAY 15 1997

### LAND CORNER RECORDATION CERTIFICATE Filing Requirement of Act 74, Mich. P.A. 1970

For corners in  
CHEBOYGAN

Located In: Corner Code #

(County)

1. Public Land Survey T 38N R 3W M-5  
T 38R 2W  
T 38R 2W  
T 38R 2W  
2. Property Controlling S    T    R     
in Section S    T    R     
3. Miscellaneous S    T    R     
Property in Sec. S    T    R   

RECEIVED  
FOR RECORD

96 OCT 30 PM 12:12

*Joanna Spray*

CLERK/REGISTER  
CHEBOYGAN COUNTY, MICHIGAN

Register of Deeds Stamp & File Number

4. Lot No.           , Recorded Plat           

5. Private Claims           

I, JAMES H. GRANGER, in a field survey on SEPTEMBER 24, 19 96, do hereby state that under requirements of P.A. 74, Michigan P.A. of 1970, the corner points mentioned in lines 1 and 2 above were in conformance with regulations and rules therefore as required in the current manual of survey instructions of the United States Department of the Interior, Bureau of Land Management or by a decree of a Court of Law and/or that the corner points mentioned in lines 3, 4 and 5 above were in conformance with the rules of the Michigan Board of Land Surveyors or by a Decree of a Court of Law; established, re-established, monumented, recovered, found as expressed below:

NOTE: Not more than 2 corners, all in the same town and range, may be recorded on this certificate.

	A	B	C	D	E	F	G	H	I	J	K	L	M
1													
2													
3													
4													
5													
6													
7													
8													
9													
10													
11													
12													
13													


A. Description of original monument and accessories and/or subsequent restoration:

1840 Original Survey Set wood post 12" Spruce N46°E 12 lks  
John Mullett 10" ash S11°W 17 lks  
1964 DNR - LCRC 1" pipe w/4" brass cap  
Ken Larsen # 10695  
1972 Survey 1" pipe w/brass cap  
Orlando Doyle # 7319  
1973 LCRC 1" pipe w/brass cap

B. Description of corner evidence found and/or method applied in restoring or reestablishing corner:

Found DNR monument with brass cap.

*Marvin A. Ruse*

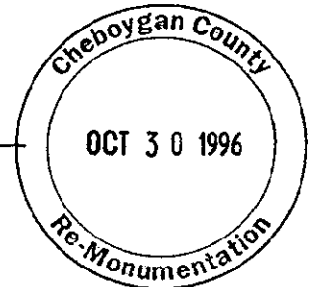


LIBER 010 PAGE 172

C. Description of monument for corner and accessories established to perpetuate locating the position of the corner

also corner A-5, T38N, R2W

DNR monument with brass cap

12" Poplar S54°E 79.37' Set nail w/tag  
12" Poplar S20°E 53.42' Set nail w/tag  
4" Birch S20°W 60.28' Set nail w/tag  
6" Birch S49°W 77.31' Set nail w/tag

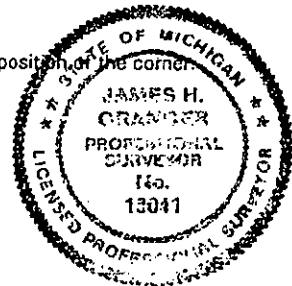

Signed by

*James H. Granger*

Date

10-10-96

Surveyor's Michigan License No. 16041