

MICHIGAN  
DEPARTMENT OF CONSERVATION  
FORESTRY DIVISION

LAND CORNER RECORD

T. 38 N. R. 2 W


Cheboygan COUNTY

DESCRIPTION OF CORNER 1/4 corner common to sections 9 and 16

CORNER MONUMENT Set 1" pipe with 4" aluminum cap

DATE MONUMENT PLACED AND WITNESSED July 16, 1965

WITNESSES TO CORNER.....

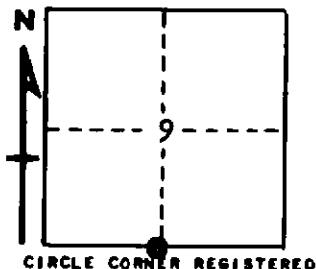

10" Spruce - N54 E 20.5

7" Balsam - S 2 W 43.1

AND

DESCRIPTION IN DETAIL AS TO HOW CORNER WAS LOCATED AND IDENTIFIED OR RESTORED.

This corner was set by proportionate measurement between Section corners. Can find no evidence of original witnesses or previous corner.

SURVEYOR'S SEAL

SIGNED

Kenneth J. Osting  
REGISTERED LAND SURVEYOR #10068

DATE October 19, 1965