

SURVEY &  
REMONUMENTATION

AUG 20 1996

COMMISSION

Approved By Delta County  
Land Survey Remonumentation  
Peer Group Under Act 345 Of  
P.A. Of 1990 On June 27, 1996

LAND CORNER RECORDATION CERTIFICATE

Filing Requirement of Act 74, Mich. P.A. 1970

Robert Schumaker  
Acting Chairman

For corners in  
DELTA

(County)

Located In:

Corner Code ##

1. Public Land Survey

T 38 N R 23 W

E-2

T R

T R

T R

2. Property Controlling  
in Section

S T R

S T R

3. Miscellaneous

S T R

Property in Sec.

S T R

4. Lot No. , Recorded Plat

5. Private Claims

E-2 [W1/4 COR S.4]

E-5 [NW COR S.16]

Recorded 28 June 1996  
9:00 A.M. 8 Page 142  
at o'clock in Liber Page  
William C. Thomas Reg. of Deeds.  
Delta County, Michigan  
Register of Deeds Stamp & File Number

I, M.P. DAVIS

, in a field survey on MAY, 19 96,  
do hereby certify that under requirements of P.A. 74, Michigan P.A. of 1970, the corner points mentioned  
in lines 1 and 2 above were in conformance with regulations and rules therefore as required in the  
current manual of survey instructions of the United States Department of the Interior, Bureau of Land  
Management or by a decree of a Court of Law and/or that the corner points mentioned in lines 3, 4 and 5  
above were in conformance with the rules of the Michigan Board of Land Surveyors or by a Decree of a  
Court of Law; established, re-established, monumented, re-monumented, recovered, found as  
expressed below:

NOTE: Not more than 4 corners, all in the same town and range, may be recorded  
on this certificate.

A. Description of original monument and accessories and/or subsequent restoration:

E-2 [W1/4 COR S.4] WOOD POST - A.MERRYWEATHER, D.S. - 1847 (BIRCH 07"-N20°W-06 LINKS) (TAMARACK 07"-S21°E-13 LINKS)

M.S.McNABB-1946-ESTABLISHED CORNER "1/2 DIST & DIRECT LINE BETWEEN CORNERS (NORWAY 9" N41°W 12.5')(NORWAY 8" S5°E 13.7')

E-5 [NW COR S.16] WOOD POST - A.MERRYWEATHER, D.S. - 1847 (BIRCH 06"-N32°W-25 LINKS) (BIRCH 06"-S40°E-07 LINKS)

D.A.BROTHERTON-1910-FROM ORIGINALS RESET STEEL BLADE-BT STAKES NW & SE 20'


M.S.McNABB-1917-ID CORNER BY BT STAKES IN PREVIOUS SURVEYS

M.DAVIS-1973-FOUND I.P. IN STONE MOUND & NOTED FOLLOWING NEW BT'S (MAPLE 12" N27°W 58.5')(TWIN MAPLE 20" S2°E 45.9')(PP N76°E  
116.4') REC'D LIBER 1 OF LCR'S PG. 294

B. Description of corner evidence found and/or method applied in restoring or reestablishing corner:

E-2 [W1/4 COR S.4] FOUND IN PLACE McNABB'S 1946 WOOD POST SCRIBED "1/4", ID CORNER MONUMENT FROM  
McNABB'S SE BT WHICH IS STILL GREEN. ACCEPTED THE EXISTING MONUMENT AS BEING A CAREFUL AND  
FAITHFUL PERPETUATION OF THE POSITION OF THE ORIGINAL CORNER.

E-5 [NW COR S.16] FOUND IN PLACE AS FOUND BY MYSELF IN 1973 AND RECORDED IN LIBER 1 OF LCR'S ON PAGE  
294. SE MAPLE BT AS NOTED IN 1973 STILL GREEN. ACCEPTED EXISTING MONUMENT AS BEING A CAREFUL AND  
FAITHFUL PERPETUATION OF THE POSITION OF THE ORIGINAL CORNER.

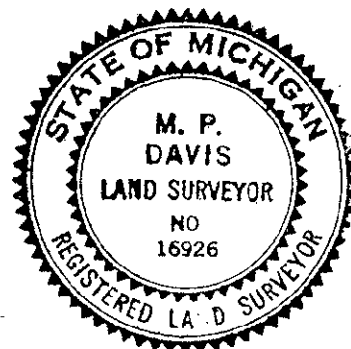

C. Description of monument for corner and accessories established to perpetuate locating the position of the corner:

E-2 REPLACED EXISTING MONUMENT W/A 4" X 4" X 36" CONC. MONUMENT W/A 3" BRASS CAP STAMPED TO ID THE CORNER POSITION.

RED PINE 7"	SPRUCE 5"	RED PINE 6"	SURVEY MONUMENT SIGN POST
N43°W	N67°E	S57°E	WEST
8.21'	14.54'	22.05'	1.65' (TO FACE)

E-5 SET OVER EXISTING MON & RAISED TO ROAD SURFACE W/A MON BOX A 5/8" X 18" REBAR W/A 3 1/4" ALUMN CAP STAMPED TO ID THE COR POSITION.

DRILL HOLE IN FIELD STONE	DRILL HOLE IN FIELD STONE	DRILL HOLE IN FIELD STONE	SURVEY MONUMENT SIGN POST
N51°W	S02°W	S58°W	S45°E
49.98'	32.32'	45.11'	27.10' (TO FACE)

NOTE: BEARINGS TO REFERENCE OBJECTS ARE MAGNETIC - DISTANCES ARE TO A NAIL IN THE CENTER OF THE OBJECT UNLESS NOTED OTHERWISE

Signed by

M.P. Davis

Date

6/19/96

Surveyor's Michigan License No.

16926