SURVEY & REMONUMENTATION

MAR 2 1 1997

() DELTA COUNTY CODE No.

Approved by Delta County Land Survey Remonumentation

Peer Group	Under Act	345 Of
P.A. Qf 1990 On		

COMMISSION

For corners in

5. Private Claims

DELTA

LAND CORNER RECORDATION CERTIFICATE Filing Requirement of Act 74, Mich. P.A. 1970

	Mesorded Jan 21997
	at 3:00 o'c'ook PM Liser 8 Page 207
1	Delta County, MI Reg. of Desds

6

acting Chairman

Located In: Corner Code ## **Public Land Survey** T 38 N R 23 W R Property Controlling in Section S Miscellaneous Property in Sec. S Т

 
___, Recorded Plat_

Register of Deeds Stamp & File Number

E-4 [W1/4 COR 9] M-2/3 [MC COR AT LAKE MICHIGAN] in a field survey on _ MAY do hereby certify that under requirements of P.A. 74, Michigan P.A. of 1970, the corner points mentioned in lines 1 and 2 above were in conformance with regulations and rules therefore as required in the current manual of survey instructions of the United States Department of the Interior, Bureau of Land Management or by a decree of a Court of Law and/or that the corner points mentioned in lines 3, 4 and 5

above were in conformance with the rules of the Michigan Board of Land Surveyors or by a Decree of a Court of Law; established, re-established, monumented, re-monumented, recovered, found as expressed below:

10 11 NOTE: Not more than 4 corners, all in the same town and range, may be recorded on this certificate. 12



- E-4 [W1/4 COR S.9] WOOD POST A.MERRYWEATHER, D.S. 1847 (CEDAR 08"-N70"W-06 LINKS) (CEDAR 07"-S30"E-12 LINKS) D.A.BROTHERTON-1921-ORIGINALS DESTROYED, ESTABLISHED 1/2 DISTANCE BETWEEN CORNERS, SET STAKE & BT STAKE WEST 33' M.DAVIS-1973-SET RR SPIKE-FD BROTHERTON'S N1/16 IRON ROD & NW COR OF SEC 9. EXTENDED LINE SOUTH FROM NW COR THROUGH: THE N1/16 & ESTABLISHED 1/4 COR ON THIS LINE & PROPORTIONATE DISTANCE SOUTH OF THE N1/16-NOTED THE FOLLOWING NEW BT'S (CEDAR 09"-S58°E-42.1') (PP-S50°N-39.3')(C/L COUNTY ROAD-WEST-8') REC'D IN LIBER 1 OF LCR'S PG 293
- M-2/3 [MC COR AT LAKE MICH.] WM.A.BURT, D.S. 1844 WOOD POST (CEDAR 08°-N02°E-200 LINKS) D.A.BROTHERTON-1921-"OLD M.C. IN PLACE"-REMARK CONTAINED IN BROTHERTON'S RECORDS OF HIS SURVEY OF H.O.BROTHERTON'S LAKE SHORE ADDITION AS REC'D IN LIBER "B" OF PLATS, PG. 35
- B. Description of corner evidence found and/or method applied in restoring or reestablishing corner:
 - E-4 [W1/4 COR S.9] FOUND IN PLACE, THIS DATE, RR SPIKE AS SET BY MYSELF IN 1973, ID FROM CEDAR BT SE, NOW A 3' HIGH STUMP. ACCEPTED EXISTING MONUMENT AS A CAREFUL & FAITHFUL REBSTABLISHMENT OF THE LOCATION OF THE POSITION OF THE ORIGINAL CORNER.
 - M-2/3 [NC AT LAKE MICH.] FOUND IN PLACE A 3/4" x 42" IRON PIN. ID THAT AS BEING A PERPETUATION OF THE "OLD MC CORNER" FOUND IN PLACE BY BROTHERTON IN 1921 BY MEASUREMENTS TO ADJOINING PLAT CORNERS IN THE PLAT OF H.O.BROTHERTON'S LAKE SHORE ADD. ACCEPTED EXISTING MONUMENT AS BEING THE BEST AVAILABLE EVIDENCE AS TO THE LOCATION OF THE POSITION OF THE ORIGINAL CORNER. DISTANCE NORTH TO E1/4 COR OF SEC 1 CHECKS WELL WITH THE "GLO" DISTANCE.



REVISED JAN., 1983

	•							
C.	Description of monument	for corner and	accessories	established	to perpetuate	locating the i	position of t	he corner

E-4 REPLACED EXIST	ING MON W/A s	/8" x 18" REBAR	W/A 31/48 ALUM CAE	STAMPED TO ID TH	E COR POSITION,	RAISED TO GRADE W/A	MON BOX.
SPRUCE 05°	CEDAR 6"	POWER POLE	SURVEY MONUMEN		·		

\$38°W \$38°E N30°E WEST 60.73 49.94 27.77' (TO FACE)

M-2/3 REPLACED EXISTING MON W/A BERNTSEN ALNB30 ALUMN MON W/A 31/4" CAP STAMPED TO 1D THE CORNER POSITION.

5/8" IRON PIPE (PLAT COR.) NOTE: NO OTHER WIT'S AVAILABLE, COR IS LOCATED IN ASH 6" ASH 6" SURVEY MONUMENT SIGN POST N25°W NIOW SOUTH S61°W OPEN MARSH LAND ON THE WEST SIDE OF AN OPEN 45.00' 47.42 3.02' (TO FACE) 11.58DRAIN DITCH.

NOTE: BEARINGS TO REFERENCE OBJECTS ARE MAGNETIC - DISTANCES ARE TO A NAIL IN THE CENTER OF THE OBJECT UNLESS NOTED OTHERWISE

JBSH

Signed by . _ Date _ Surveyor's Michigan License No. 16926 FORM APPROVED BY MICHIGAN STATE BOARD OF LAND SURVEYORS, JAN. 28, 1971 REVISED MAY 14, 1975