

JAN 5 2000

SECTION

LAND CORNER RECORDATION CERTIFICATE  
Filing Requirement of Act 74, Mich. P.A. 1970

Approved By Delta County  
Land Survey Remonumentation  
Peer Group Under Act 345 Of  
P.A. Of 1990 On Dec 28, 1999

Robert Schmeling  
Chairman

For corners in

DELTA (County)	Located In:	Corner Code #
1. Public Land Survey	T 39 NR 18 W	A-13 SAME ✓
	T 39 NR 19 W	M-13
	T 38 NR 18 W	A-1
	T 38 NR 19 W	M-1 CORNERS
2. Property Controlling in Section	S T R	
	S T R	
3. Miscellaneous Property in Sec.	S T R	
	S T R	

A-13 [SW COR SEC 31 T39N R18W]

4. Lot No. \_\_\_\_\_, Recorded Plat \_\_\_\_\_  
5. Private Claims \_\_\_\_\_

I, M.P. DAVIS, in a field survey on NOVEMBER, 19 99 do hereby state that under requirements of P.A. 74, Michigan P.A. of 1970, the corner points mentioned in lines 1 and 2 above were in conformance with regulations and rules therefore as required in the current manual of survey instructions of the United States Department of the Interior, Bureau of Land Management or by a decree of a Court of Law and/or that the corner points mentioned in lines 3, 4 and 5 above were in conformance with the rules of the Michigan Board of Land Surveyors or by a Decree of a Court of Law; established, re-established, monumented, recovered, found as expressed below:

NOTE: Not more than 2 corners, all in the same town and range, may be recorded on this certificate.

0104-00  
2:00 O'CLOCK PM  
DEER 9 PAGE 188  
William C. Thorne  
REGISTERED LAND SURVEYOR

Register of Deeds Stamp & File Number


	A	B	C	D	E	F	G	H	I	J	K	L	M
1													
2	6		5		4		3		2		1		
3													
4	7		8		9		10		11		12		
5													
6	18		17		16		15		14		13		
7													
8	19		20		21		22		23		24		
9													
10	30		29		28		27		26		25		
11													
12	31		32		33		34		35		36		
13													

A. Description of original monument and accessories and/or subsequent restoration:

- A-13 [SW COR SEC 31] JOHN BURT, D.S.-1845-WOOD POST (BEECH 10" S50°W 34 LINKS)(BEECH 10" N82°E 29 LINKS M.S.McNABB-1916-ID FROM ORIGINALS. NO DESCRIPTION OF MONUMENT FOUND OR NEW BT'S NOTED. BILLY D. BUCKLER-1961-NO CORNER EVIDENCE FOUND-REESTABLISHED CORNER POSITION BY DOUBLE PROPORTIONATE DISTANCE BETWEEN CORNERS 1 MILE WEST, NORTH & SOUTH AND SECTION CORNER 2 MILES EAST. SET 1" I.P. W/A 4" BRASS CAP STAMPED TO ID THE CORNER POSITION, FROM WHICH A 12" W.PINE N78°E 05 LINKS-H.MAPLE 14" S41°W 13 LINKS-H.MAPLE 8" S20°E 45 LINKS

B. Description of corner evidence found and/or method applied in restoring or reestablishing corner:

- A-13 [SW COR SEC 31] FOUND IN PLACE A 1" I.P. W/A 4" BRASS CAP STAMPED TO ID THE CORNER POSITION. ID SAME AS THAT BEING SET IN 1961 BY BILLY D. BUCKLER FROM HIS SW BT WHICH IS STILL GREEN AND NE BT WHICH IS A 3' HIGH STUMP WITH IRON MARKS STILL PLAIN ON THE LOWER BLAZE. ACCEPTED AS BEING A CAREFUL AND FAITHFUL REESTABLISHMENT OF THE LOCATION OF THE POSITION OF THE ORIGINAL CORNER.

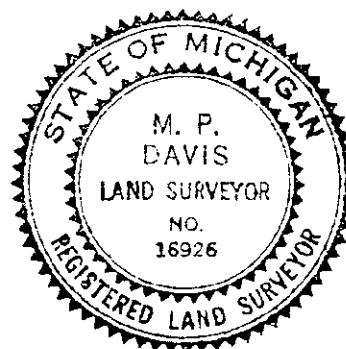

C. Description of monument for corner and accessories established to perpetuate locating the position of the corner:

- A-13 DID NOT DISTURB EXISTING MONUMENT AND NOTED NEW BT'S  
MAPLE 09" MAPLE 07" MAPLE 07" MAPLE 17" (OLD BT)  
N82°W N42°E S33°E S45°W  
16.70' 24.17' 10.18' 09.24'

NOTE: BEARINGS TO REFERENCE OBJECTS ARE MAGNETIC-DISTANCES ARE TO A NAIL W/A DELTA COUNTY REFERENCE TAG, UNLESS OTHERWISE NOTED.

Signed by M.P. Davis  
Surveyor's Michigan License No. 16926

Date 12/28/99