

SURVEY & REMONUMENTATION

FEB 02 1999

SECTION

LAND CORNER RECORDATION CERTIFICATE  
Filing Requirement of Act 74, Mich. P.A. 1970

Approved By Delta County  
Land Survey Remonumentation  
Peer Group Under Act 345 Of  
P.A. Of 1990 On December 30, 1998  
*Robert Delamater*  
Chairman

For corners in  
DELTA  
(County)

Located In: Corner Code ##

- |                                    |               |                   |
|------------------------------------|---------------|-------------------|
| 1. Public Land Survey              | T 40 N R 19 W | 3 - 6             |
|                                    | T 40 N R 19 W | MC E/F - 9 (14) ✓ |
|                                    | T R           |                   |
|                                    | T R           |                   |
| 2. Property Controlling in Section | S T R         |                   |
|                                    | S T R         |                   |
| 3. Miscellaneous Property in Sec.  | S T R         |                   |
|                                    | S T R         |                   |

Recorded Jan 11 1999  
at 9:45U sec. AM  
Lib. 9 pgs 130  
*Walter C. Thum*  
Delta County, MI Reg. of Deeds

Register of Deeds Stamp & File Number

4. Lot No. , Recorded Plat  
5. Private Claims E-6 [W1/4 COR SEC 16] E/F-9 [M.C. SEC 21/28]

	A	B	C	D	E	F	G	H	I	J	K	L	M
2	6	5		4		3		2		1			
3													
4	7	8		9		10		11		12			
5													
6	18	17		16		15		14		13			
7													
8	19	20		21		22		23		24			
9													
10	30	29		28		27		26		25			
11													
12	31	32		33		34		35		36			
13													

I, M.P. DAVIS, in a field survey on DECEMBER, 19 98, do hereby certify that under requirements of P.A. 74, Michigan P.A. of 1970, the corner points mentioned in lines 1 and 2 above were in conformance with regulations and rules therefore as required in the current manual of survey instructions of the United States Department of the Interior, Bureau of Land Management or by a decree of a Court of Law and/or that the corner points mentioned in lines 3, 4 and 5 above were in conformance with the rules of the Michigan Board of Land Surveyors or by a Decree of a Court of Law; established, re-established, monumented, re-monumented, recovered, found as expressed below:

NOTE: Not more than 4 corners, all in the same town and range, may be recorded on this certificate.

A. Description of original monument and accessories and/or subsequent restoration:

E-6 [W1/4 COR SEC. 16] A.MERRYWEATHER, D.S. - 1848 - WOOD POST (BALSAM 06"-S28°W-08 LINKS) (BALSAM 08"-N75°E-15 LINKS)  
NO RECORD EVIDENCE OF SUBSEQUENT CORNER RECOVERY AND/OR MONUMENTATION.


E/F-9 [M.C. SEC. 21/28] A.MERRYWEATHER, D.S. - 1848 - WOOD POST (WHITE PINE 30"-N10°E 85)

D.A.BROTHERTON - 1910 - FIELD NOTES OF PRIVATE PROPERTY SURVEY SHOWS M.C. IN PLACE AT "GLO" DISTANCE WEST OF 1/4 CORNER COMMON TO SEC'S 21/28 - NO WIT'S NOTED OR DESCRIPTION OF MONUMENT GIVEN.

B. Description of corner evidence found and/or method applied in restoring or reestablishing corner:

E-6 [W1/4 COR SEC. 16] NO CORNER EVIDENCE FOUND. RESTORED CORNER POSITION AT MIDPOINT BETWEEN AND ON LINE WITH THE SECTION CORNERS 1/2 MILE NORTH & SOUTH.

E/F-9 [M.C. SEC. 21/28] NO CORNER EVIDENCE FOUND. EXTENDED LINE FROM THE MEANDER CORNER FOUND TO THE EAST OF THE 1/4 CORNER COMMON TO SEC'S 21/28 WEST THRU THE 1/4 CORNER AND SET THE MEANDER CORNER AT THE "GLO" DISTANCE WEST OF THE 1/4 CORNER. THIS POSITION FALLS IN A COMPOST PILE NEAR THE SOUTH END OF A RESIDENTIAL GARAGE AND COULD NOT BE MONUMENTED. A REFERENCE MONUMENT WAS PLACED ON THIS LINE 4.9' EAST OF THE M.C. POSITION.

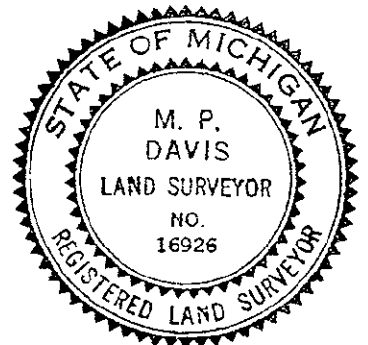

C. Description of monument for corner and accessories established to perpetuate locating the position of the corner:

E-6 SET BERNTSEN ALNB30 ALUMN MON. W/A 3 1/4" CAP STAMPED TO ID THE CORNER POSITION.  
MAPLE 11" BALSAM 06" MAPLE 13" MAPLE 11" SURVEY MONUMENT SIGN POST  
N30°E S20°E S62°W N42°W WEST  
10.38' 19.39' 14.69' 11.17' 1.29' (TO FACE)

E/F-9 (REF. MON) SET A 5/8" X 18" REBAR W/A 2" ALUM CAP STAMPED TO ID THE CORNER POSITION.  
SW COR OF LEANTO SHED @ HOUSE NO. 313775 WOOD FENCE POST OF SPLIT RAIL FENCE SE CORNER OF GARAGE  
S84°E S17°E S30°W N64°W  
38.50' 49.82' 52.73' 2.82'

NOTE: BEARINGS TO REFERENCE OBJECTS ARE MAGNETIC-DISTANCES ARE TO NAIL W/A DELTA COUNTY REFERENCE TAG, UNLESS OTHERWISE NOTED.

Signed by M.P. Davis Date 12/28/98

Surveyor's Michigan License No. 16926

LIBER 0009 PAGE 130