

REMONUMENTATION

FEB 22 1996

COMMISSION

LAND CORNER RECORDATION CERTIFICATE
Filing Requirement of Act 74, Mich. P.A. 1970

Approved By Delta County
Land Survey Remonumentation
Peer Group Under Act 345 Of
P.A. Of 1990 On May 12, 1994
Robert B. Chisholm
Acting Chairman

For corners in
DELTA
(County)

Located In: Corner Code #

1. Public Land Survey T 43 N R 23 W C-11 & C-13
T 42 N R 23 W C-1
T 42 N R 23 W
T 42 N R 23 W
2. Property Controlling S T R
in Section S T R
3. Miscellaneous S T R
Property in Sec. S T R

MAY 13 1994

Recorded
9:00 o'clock AM In Liber 7 Page 398
Walter C. Thum Reg. of Deeds.
Delta County, Michigan
Register of Deeds Stamp & File Number


4. Lot No. , Recorded Plat
5. Private Claims C-11 [NW COR SEC 32] C-13 [SW COR SEC 32]
SAME AS C-1 T 42 N R 23 W

I, M.P. DAVIS, in a field survey on FEBRUARY, 19 94
do hereby certify that under requirements of P.A. 74, Michigan P.A. of 1970, the corner points mentioned
in lines 1 and 2 above were in conformance with regulations and rules therefore as required in the
current manual of survey instructions of the United States Department of the Interior, Bureau of Land
Management or by a decree of a Court of Law and/or that the corner points mentioned in lines 3, 4 and 5
above were in conformance with the rules of the Michigan Board of Land Surveyors or by a Decree of a
Court of Law; established, re-established, monumented, re-monumented, recovered, found as
expressed below:

NOTE: Not more than 4 corners, all in the same town and range, may be recorded
on this certificate.

- A. Description of original monument and accessories and/or subsequent restoration:
C-11 [NW COR SEC 32] MARTIN M. HALL, D.S. - 1853 - CEDAR POST (TAMARACK 18"-S80°W-04 LINKS) (SPRUCE 10"-N50°E-148 LINKS)
M.S. McNABB - 1914 - ID CORNER POSITION FROM ORIGINALS - SET NEW STAKE - NO NEW WIT'S NOTED
C-13 [SW COR SEC 32] Wm. A. BURT, D.S. - 1841 - WOOD POST (MAPLE 07"-N51°E-22 LINKS) (CEDAR 10"-N32°W-09 LINKS)
J.E. GRINGRASS - 1912 - ID CORNER POSITION FROM 4" CEDAR STAKE IN C/L E-W ROAD NO NEW WIT'S NOTED.
M.S. McNABB - 1914 - ID CORNER POSITION FROM ORIGINALS & CEDAR POST IN ROAD C/L - SET BT STAKES NW & SE 33'

- B. Description of corner evidence found and/or method applied in restoring or reestablishing corner:
C-11 [NW COR SEC 32] FOUND 2" IP W/A BRASS CAP STAMPED TO ID THE CORNER POSITION - CORNER MONUMENTED
BY OLIVER MINING COMPANY, DATE UNKNOWN. ACCEPTED AS BEING A CAREFUL & FAITHFUL PERPETUATION OF
THE POSITION OF THE ORIGINAL CORNER.
C-13 [SW COR SEC 32] FOUND 1" IP 32" BELOW ROAD SURFACE, DISTANCES E & W TO OCCUPATION FITS WELL WITH
RECORD & DISTANCE NORTH TO 1/4 LINE FENCE FITS WELL WITH McNABB'S SURVEY DISTANCE. ACCEPTED EXIST-
ING MONUMENT AS BEING A CAREFULL & FAITHFUL PERPETUATION OF THE POSITION OF THE ORIGINAL CORNER.

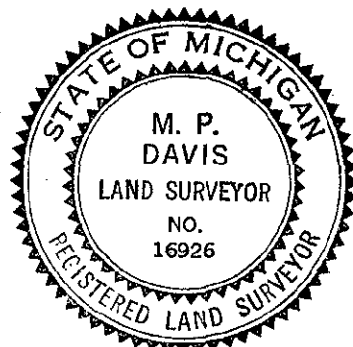

- C. Description of monument for corner and accessories established to perpetuate locating the position of the corner:
C-11 DID NOT DISTURB EXISTING MONUMENT.
TAMARACK 8" TAMARACK 8" TAMARACK 9" TAMARACK 9" SURVEY MONUMENT SIGN POST
N36°E N29°W S56°W S19°E SOUTH
49.45' 9.45' 30.85' 50.59' 2.55' (TO FACE)
C-13 SET, OVER EXISTING MONUMENT, A 5/8" X 18" REBAR W/A 3-1/4" ALUMN CAP STAMPED TO ID THE CORNER POSITION.
USGS BM DISK IN CONC MONUMENT CORNER FENCE POST
N48°E S47°W
53.20' 47.00'

NOTE: BEARINGS TO REFERENCE OBJECTS ARE MAGNETIC & DISTANCES ARE TO A NAIL W/A REFERENCE TAG, UNLESS NOTED OTHERWISE.

Signed by M.P. Davis Date 5/6/94
Surveyor's Michigan License No. 16926