

DEC 18 1995

COMMISSION

LAND CORNER RECORDATION CERTIFICATE
Filing Requirement of Act 74, Mich. P.A. 1970

RECORDED

NOV 22 PM 2:31

For corners in

Dickinson (County)	Located In:	Corner Code #
1. Public Land Survey	T 39N R 29W	D-5
D-5 8 D-7 17	T 39N R 29W	D-7
17 20	T R	
	T R	
2. Property Controlling	S T R	
in Section	S T R	
3. Miscellaneous	S T R	
Property in Sec.	S T R	

REGISTER OF DEEDS
JACKSON COUNTY
JAN 23 1996

Register of Deeds Stamp & File Number

4. Lot No. _____ Recorded Plat _____
5. Private Claims _____

I, James H. Moore, in a field survey on September 6, 19 95, do hereby certify that under requirements of P.A. 74, Michigan P.A. of 1970, the corner points mentioned in lines 1 and 2 above were in conformance with regulations and rules therefore as required in the current manual of survey instructions of the United States Department of the Interior, Bureau of Land Management or by a decree of a Court of Law and/or that the corner points mentioned in lines 3, 4 and 5 above were in conformance with the rules of the Michigan Board of Land Surveyors or by a Decree of a Court of Law; established, re-established, monumented, re-monumented, recovered, found as expressed below:

NOTE: Not more than 4 corners, all in the same town and range, may be recorded on this certificate.

A	B	C	D	E	F	G	H	I	J	K	L	M
2	6	5	4	3	2	1						
3												
4	7	8	9	10	11	12						
5												
6	18	17	16	15	14	13						
7												
8	19	20	21	22	23	24						
9												
10	30	29	28	27	26	25						
11												
12	31	32	33	34	35	36						
13												

A. Description of original monument and accessories and/or subsequent restoration:

D-5 Original Corner - Wood Post Set by J. H. Mullet 1849
D-7 Original Corner - Post Set by J. H. Mullet 1849

Original Bearing Trees

6" Aspen N28°E 5 Links
6" Aspen S18°W 4 Links

Original Bearing Trees

10" S. Pine S60°E 14 Links
18" Y. Pine N28°E 35 Links

B. Description of corner evidence found and/or method applied in restoring or reestablishing corner:

D-5 Found 5/8" Rebar by Bob Perkins 12027 as Per Sundberg, Carlson's Notes

Fence Lines Run West and South
350' West of Top of Hill

Record Research On File With Register of Deeds

D-7 Found 1" Iron Pipe at Fence Intersection as Per Sundberg, Carlson's Notes

4 Way Fence Corner
Tree Line to East

Record Research On File With Register of Deeds

ACCEPTED BY THE DICKINSON COUNTY
SURVEY PEER GROUP AS THE OFFICIAL
CORNER UNDER MICHIGAN PUBLIC ACT
345 OF 1990 AT A MEETING HELD ON

11-20-95

RDP

COUNTY REPRESENTATIVE

C. Description of monument for corner and accessories established to perpetuate locating the position of the corner:

D-5 Replaced 5/8" Rebar With New Dickinson County Capped Aluminum Monument. Monument Stamped to Identify Corner. Referenced as Follows:

6" Red Pine N24°E 43.40'
7" Red Pine N71°E 34.23'
11" White Pine S63°W 62.18'
10" Oak N75°W 44.85'
Carsonite Rail South 1.05'

D-7 Drove New Dickinson County Capped Aluminum Monument Inside Existing 1" Iron Pipe. Monument Stamped to Identify Corner. Referenced as Follows:

4" Oak N47°E 3.88'
5" J. Pine S56°E 6.40'
Existing 16"
Dead Oak S19°W 21.95'
Existing 14"
Oak S40°W 42.68'
6" W. Pine S65°W 25.95'
Carsonite Rail West 1.0'


All Bt's Have 10 d Galv. Nails and Washers

All Bt's Have 10 d Galv. Nails and Washers

Signed by James H. Moore

Date 11/20/95

Surveyor's Michigan License No. 28423

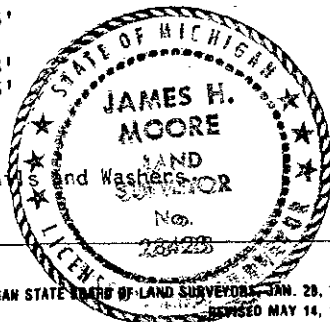

204