

# SURVEY & REMONUMENTATION

DEC 18 1995

COMMISSION

## LAND CORNER RECORDATION CERTIFICATE

Filing Requirement of Act 74, Mich. P.A. 1970

RECORDED

NOV 21 11:26

For corners in

Dickinson

(County)

Located In:

Corner Code #

1. Public Land Survey

T 40N R 29W

A-11

T R

A-12

T R

T R

2. Property Controlling  
in Section

S T R

S T R

3. Miscellaneous

S T R

Property in Section

S T R

4. Lot No. , Recorded Plat

5. Private Claims

Register of Deeds Stamp & File Number

I, Robert F. Perkins, in a field survey on Oct. 10, 19 95,  
do hereby certify that under requirements of P.A. 74, Michigan P.A. of 1970, the corner points mentioned  
in lines 1 and 2 above were in conformance with regulations and rules therefore as required in the current  
manual of survey instructions of the United States Department of the Interior, Bureau of Land  
Management or by a decree of a Court of Law and/or that the corner points mentioned in lines 3, 4 and  
5 above were in conformance with the rules of the Michigan Board of Professional Surveyors or by a  
Decree of a Court of Law; established, re-established, monumented, re-monumented, recovered, found  
as expressed below:

**NOTE: Not more than 4 corners, all in the same town and range, may be recorded  
on this certificate.**

### A. Description of original monument and accessories and/or subsequent restoration:

A-11 Northwest Quarter, Section 31  
Post J. Mullett, D.S. 1848  
Original Bearing Trees  
Sugar 8" N20°W 30 Lks.  
Hemlock 10" S35°W 26 Lks.

A-12 West 1/2 Corner, Section 31  
Post J. Mullett, D.S. 1849  
Original Bearing Trees  
Aspen 12" N20°W 12 Lks.  
Aspen 12" S20°W 15 Lks.

ACCEPTED BY THE DICKINSON COUNTY  
SURVEY PEER GROUP AS THE OFFICIAL  
CORNER UNDER MICHIGAN PUBLIC ACT  
345 OF 1990 AT A MEETING HELD ON

11-20-95  
RFP

### B. Description of corner evidence found and/or method applied in restoring or reestablishing corner:

COUNTY REPRESENTATIVE

A-11 No Evidence of Original Corner  
or Accessories Found.  
City of Norway Land Record (Sh. 1)  
indicates Concrete Monument in Road.  
Found Concrete Monument buried 1.7'  
in Road with Newer B.T.'s.  
Corner Researched in 1994.

A-12 No Evidence of Original Corner or  
Accessories Found.  
City of Norway Land Corner Record (Sh. 1-B)  
indicates Concrete Monument in Road 1/2 with  
Witness Corners 33' East and 33' West.  
Found P.K. Nail at above Location with  
Witness Corners East and West (Broken).  
Corner in ± 4' Fill Section.  
Corner Researched in 1994.

### C. Description of monument for corner and accessories established to perpetuate locating the position of the corner:

A-11 Placed 2 1/2" Stamped D.C. Remon. Corner  
over Concrete Monument in Monument Box.  
New Witnesses  
R. Pine 10" N70°E (M.B.) 60.60'  
Elm 12" S37°E (M.B.) 76.06'  
Elm 16" N10°W (M.B.) 59.97'  
Lynn 8" S54°W (M.B.) 38.52'  
Set 3" Stamped D.C. Remon. W.C.,  
N40°W (M.B.) 37.0'  
Placed Carsonite stake at Witness Corner.


A-12 Set 2 1/2" Stamped D.C. Remon. Monument  
in Monument Box at above Location.  
New Witnesses  
Cherry 8" S74°E (M.B.) 61.65'  
Spruce 12" S20°E (M.B.) 181.20'  
X Cut on 4' Boulder S40°W (M.B.) 110.00'  
P. Pole #71-2444 S88°W (M.B.) 33.11'  
Carsonite Marker S80°E (M.B.) 33.00'

Signed by Robert F. Perkins

Date Nov. 7, 1995

Surveyor's Michigan License No. 12027

FORM APPROVED BY MICHIGAN STATE BOARD OF PROFESSIONAL SURVEYORS, JAN. 28, 1971

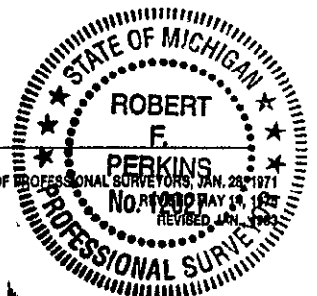

181