

SURVEY & REMONUMENTATION

RECORDED

DEC 18 1995

LAND CORNER RECORDATION CERTIFICATE

NOV 21 AM 11:27

COMMISSION

Filing Requirement of Act 74, Mich. P.A. 1970

For corners in
Dickinson
(County)

Located In:

Corner Code #

1. Public Land Survey T 41N R 27W
- T _____ R _____
- T _____ R _____
- T _____ R _____
2. Property Controlling S _____ T _____ R _____
- in Section S _____ T _____ R _____
3. Miscellaneous S _____ T _____ R _____
- Property in Section S _____ T _____ R _____

A-5
B-3
B-5
C-5

RECORDED BY
JAN 1996

Register of Deeds Stamp & File Number

4. Lot No. _____, Recorded Plat _____
5. Private Claims _____

	A	B	C	D	E	F	G	H	I	J	K	L	M
2	6	5	4	3	2	1							
3	7	8	9	10	11	12							
4	18	17	16	15	14	13							
6	19	20	21	22	23	24							
7	30	29	28	27	26	25							
8	31	32	33	34	35	36							
9													
10													
11													
12													
13													

I, Robert F. Perkins, in a field survey on Mar. 29, 1995, do hereby certify that under requirements of P.A. 74, Michigan P.A. of 1970, the corner points mentioned in lines 1 and 2 above were in conformance with regulations and rules therefore as required in the current manual of survey instructions of the United States Department of the Interior, Bureau of Land Management or by a decree of a Court of Law and/or that the corner points mentioned in lines 3, 4 and 5 above were in conformance with the rules of the Michigan Board of Professional Surveyors or by a Decree of a Court of Law; established, re-established, monumented, re-monumented, recovered, found as expressed below:

NOTE: Not more than 4 corners, all in the same town and range, may be recorded on this certificate.

A. Description of original monument and accessories and/or subsequent restoration:

A-5 S.W. Corner, Section 7
Wm. A. Burt 1847
Sugar 10" S22°E 12 L.
Sugar 6" N51½°W 35 L.

B-3 N.½ Corner, Section 7
John Burt 1850
Cedar 10" N42°W 6 L.
Tam. 12" S60°E 36 L.

B-5 S.¼ Corner, Section 7
John Burt 1850
Ironwood 12" N32°E 55 L.
Lynn 10" S58°W 20 L.

C-5 S.W. Corner, Section 7
John Burt 1850
Sugar 18" N61°E 15 L.
Lynn 10" S53°W 10 L.

ACCEPTED BY THE DICKINSON COUNTY SURVEY PEER GROUP AS THE OFFICIAL CORNER UNDER MICHIGAN PUBLIC ACT 345 OF 1990 AT A MEETING HELD

11-20-95

ROIP

COUNTY REPRESENTATIVE

B. Description of corner evidence found and/or method applied in restoring or reestablishing corner:

A-5 No Original Evidence Found
Found Iron Bar in Centerline Road in Line with Ancient E-W Fences.
Dickinson County Road Comm. Circa 1930.
Accepted as Best Available Evidence.

B-3 No Original Evidence Found.
Corner Re-Established by Single Proportionate Method from N.E. and N.W. Corners-Section 7.
Corner falls in Line of Old Fence Posts running N-S.

B-5 No Original Evidence Found.
Corner Re-Established by Single Proportionate Method from S.E. and S.W. Corners of Section 7.
Note: Existing Fence built in 1963 without Survey; ¼ Corner not in at that time; Not intended to be on Line.

C-5 No Original Evidence Found.
Found Boat Spike in Centerline Road in Line with Old N-S Fence Line. Adjacent Owner advises Pin in Road Centerline for over 50 years. Accepted as Best Available Evidence.

C. Description of monument for corner and accessories established to perpetuate locating the position of the corner:


A-5 5/8" Solid Iron Bar in Road Centerline
S. Maple N49°E (M.B.) 74.28' (Nail)
P. Pole S23°W (M.B.) 105.55' (Nail)
6" Well Casing N45°W (M.B.) 66.25'
16" CMP Culvert 2' South
D.C. REMON. WC.-East 33.00' W/Carsonite Stake

B-3 Set Dickinson County Remonumentation Stamped Marker, W/
Cedar 3" N65°W (M.B.) 14.05' (Nail) Carsonite Stake
Cedar 3" S73°E (M.B.) 18.42' (Nail)
Cedar 5" N2°W (M.B.) 12.95' (Nail)
Cedar 8" S45°W (M.B.) 29.01' (Nail)

B-5 Set DICKINSON CO. REMON. Stamped Marker
Maple 10" S70°E (M.B.) 12.38' (Nail)
Maple 16" S37°W (M.B.) 12.15' (Nail)
Maple 18" N58°W (M.B.) 18.10' (Nail)
Maple 12" N11°W (M.B.) 20.93' (Nail)

C-5 Replaced Boat Spike with DICKINSON CO. REMON. Stamped Marker in Centerline Road.
Maple 24" N62°W (M.B.) 39.60' (Nail)
J. Pine 5" N12°E (M.B.) 22.00' (Nail)
J. Pine 6" N49°E (M.B.) 29.38' (Nail)
R. Pine 8" S3°E (M.B.) 30.00' (Nail)

Signed by Robert F. Perkins
Surveyor's Michigan License No. 12027

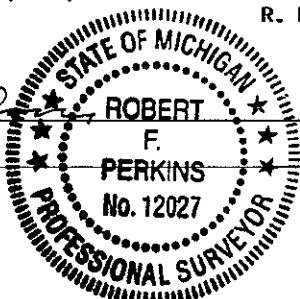

Date Mar. 29, 1995

FORM APPROVED BY MICHIGAN STATE BOARD OF PROFESSIONAL SURVEYORS, JAN. 28, 1971
REVISED MAY 14, 1975
REVISED JAN., 1983