

LAND CORNER RECORDATION CERTIFICATE  
Filing Requirement of Act 74, Mich. P.A. 1970 as Amended

For corners in

Dickinson	Located In:	Corner Code #
(County)		
NORWAY TOWNSHIP		
1. Public Land Survey	T R	
	T R	
	T R	
2. Property Controlling Section	S 12 T 41N R 29W	12
	S 12 T 41N R 29W	13
	S T R	
3. Miscellaneous Property in Sec.	S T R	
	S T R	
4. Lot No. , Recorded Plat		
5. Private Claims		

8/01/2013AD  
8/01/2013AD  
do hereby state  
that under requirements of P.A. 74, Michigan P.A. of 1970, the corner points mentioned in lines 1 and 2 above were in conformance with regulations and rules therefore as required in the current manual of survey instructions of the United States Department of the Interior, Bureau of Land Management or by a decree of a Court of Law and /or that the corner points mentioned in lines 3, 4 and 5 above were in conformance with the rules of the Michigan Board of Land Surveyors or by a Decree of a Court of Law; established, re-established, monumented, recovered, found as expressed below:

NOTE: Not more than 2 corners, all in the same town and range, may be recorded on this certificate.

A. Description of original monument and accessories and/or subsequent restoration:

(12) Center-South One-Sixteenth corner of Section 12. Not set in original survey. Found 1 1/4 inch Pipe with cuplink N19E 3.2 feet, not of record.

(09) Center-East One-Sixteenth corner of Section 12. Not set in original survey. Found 1 1/4 inch Pipe with cuplink N40E 9.0 feet, not of record.

B. Description of corner evidence found and/or method applied in restoring or reestablishing corner:

(12) Corner position established mid-point and on-line between the Center One-Quarter corner and the South One-Quarter corner of Section 12. Found Pipe not accepted.

(12) Corner position established mid-point and on-line between the Center One-Quarter corner and the East One-Quarter corner of Section 12. Found Pipe not accepted.

C. Description of monument for corner and accessories established to perpetuate locating the position of the corner:

(12) DNR monument  
7" Maple N80E 12.42' (1/16S,BT)  
9" Maple S25E 33.25' (1/16S,BT)  
9" Tw. Maple S50W 26.92' (1/16S,BT)  
4" Maple N66W 25.09' (1/16S,BT)


All trees are blazed, scribed, and painted. Measurements are to nail in side of tree, bearings are magnetic.

(13) DNR monument  
12" Cedar N02E 30.87' (1/16S,BT)  
12" Maple(clump)N82E 30.87' (1/16S,BT)  
10" Cedar S07W 59.92' (1/16S,BT)  
9" Maple N72W 23.79' (1/16S,BT)

All trees are blazed, scribed, and painted. Measurements are to nail in side of tree, bearings are magnetic.

Signed by  
Surveyor's Michigan License No. 50447

For the Michigan Department of Natural Resources,

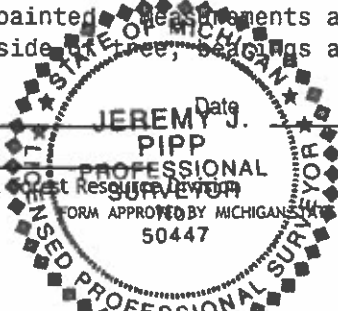

Date August 08, 2013

20262

20263

Revised May 14, 1975  
Revised Jan., 1983  
Revised Oct., 1995