

LAND CORNER RECORDATION CERTIFICATE
Filing Requirement of Act 74, Mich. P.A. 1970 as Amended

for corners in

Dickinson (County) Located In: Corner Code #
1. Public Land Survey
2. Property Controlling Section
3. Miscellaneous Property in Sec.

4. Lot No. , Recorded Plat
5. Private Claims

2/13/2013AD
2/14/2013AD
Jeremy J. Pipp, in a field survey on do hereby state
that under requirements of P.A. 74, Michigan P.A. of 1970, the corner points mentioned in lines 1 and 2 above were in conformance with regulations and rules therefore as required in the current manual of survey instructions of the United States Department of the Interior, Bureau of Land Management or by a decree of a Court of Law and /or that the corner points mentioned in lines 3, 4 and 5 above were in conformance with the rules of the Michigan Board of Land Surveyors or by a Decree of a Court of Law; established, re-established, monumented, recovered, found as expressed below:

NOTE: Not more than 2 corners, all in the same town and range, may be recorded on this certificate.

A. Description of original monument and accessories and/or subsequent restoration:

(05) Center-North One-Sixteenth corner of Section 13. Not set in original survey, no evidence of subsequent establishment.

(08) Center-West One-Sixteenth corner of Section 13. Not set in original survey, no evidence of subsequent establishment.

B. Description of corner evidence found and/or method applied in restoring or reestablishing corner:

(05) Corner position established mid-point and on-line between the Center One-Quarter corner and the North One-Quarter corner of Section 13.

(08) Corner position established mid-point and on-line between the Center One-Quarter corner and the West One-Quarter corner of Section 13. Corner is set in the Calumet Mine Road, +/-6" below grade.

C. Description of monument for corner and accessories established to perpetuate locating the position of the corner:

(05) DNR monument
17" Cedar N50E 31.83' (1/16S,BT)
11" Cedar S86E 31.76' (1/16S,BT)
11" Cedar S54W 33.17' (1/16S,BT)
11" Cedar S88W 47.39' (1/16S,BT)
(08) DNR monument
9" Cherry S83E 88.2' (1/16S,BT)
6" Cherry S15E 84.77' (1/16S,BT)
9" Spruce N78W 57.65' (1/16S,BT)
12" Poplar N08E 43.17' (1/16S,BT)

All trees are blazed, scribed, and painted. Measurements are to nail in side of tree, bearings are magnetic.

Signed by [Signature] Date July 22, 2013
Surveyor's Michigan License No. 50447

For the Michigan Department of Natural Resources, Forest Resources Division

20167
20168

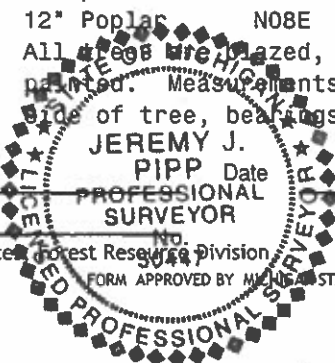


Table with 13 rows and 13 columns (A-M) for Register of Deeds Stamp & File Number. Contains numerical data for each cell.