

MICHIGAN
DEPARTMENT OF CONSERVATION
FORESTRY DIVISION

LAND CORNER RECORD

T. 41 N.R. 29W


Dickinson COUNTY

DESCRIPTION OF CORNER 1/4 Corner for Sections 7/8

CORNER MONUMENT 1" Iron Pipe with 4" Brass Cap.

DATE MONUMENT PLACED AND WITNESSED 5-2-61

WITNESSES TO CORNER..... 6" Aspen (1/4S NBT) S 43°E 04 1/2 links

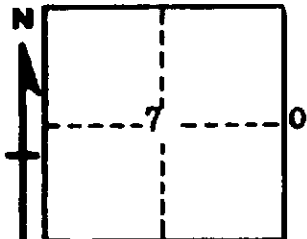

7" Aspen (1/4S NBT) S 45°W 25 links

5" Aspen (1/4S NBT) N 56°W 07 links

AND

CIRCLE CORNER REGISTERED

DESCRIPTION IN DETAIL AS TO HOW CORNER WAS LOCATED AND IDENTIFIED OR RESTORED.

This Corner was replaced from a white pine stump N36°W 31 links and Y. Pine Stump S69°E 55 links. Stumps check with Field notes, and checks fairly well with being midway and on line between section corners. No marks or other evidence on stumps.

SURVEYOR'S SEAL

SIGNED Billy D. Buckler DATE January 30, 1962
REGISTERED LAND SURVEYOR
Billy D. Buckler