

LAND CORNER RECORDATION CERTIFICATE
Filing Requirement of Act 74, Mich. P.A. 1970

For corners in
7 Dickinson

(County)

Located In:

Corner Code #

1 Public Land Survey	T 42N	R 27W	C1
	T	R	C2
	T	R	
	T	R	
2 Property Controlling in Section	S 6	T	R
	S	T	R
3 Miscellaneous Property in Sec.	S	T	R
	S	T	R

Register of Deeds Stamp & File Number

4 Lot No. , Recorded Plat

5 Private Claims

I, **Keith Sackett**, in a field survey on **JUNE 25**, 19 **91**, do hereby certify that under requirements of P.A. 74, Michigan P.A. of 1970, the corner points mentioned in lines 1 and 2 above were in conformance with regulations and rules therefore as required in the current manual of survey instructions of the United States Department of the Interior, Bureau of Land Management or by a decree of a Court of Law and/or that the corner points mentioned in lines 3, 4 and 5 above were in conformance with the rules of the Michigan Board of Land Surveyors or by a Decree of a Court of Law; established, re-established, monumented, re-monumented, recovered, found as expressed below:

NOTE: Not more than 4 corners, all in the same town and range, may be recorded on this certificate.

A. Description of original monument and accessories and/or subsequent restoration:


C1	C2	8	12
Original bearing tree. N51W 5 links found remains of cedar stump at bearing and distance. Found remains of squared cedar post at location.	Original monument and accessories not found.	Not set on original survey nor subsequently, apparently.	Not set on original survey nor subsequently, apparently.

B. Description of corner evidence found and/or method applied in restoring or reestablishing corner:

C1	C2	8	12
Restored by proportion.	Restored midway and on line.	Established by proportion between corners.	Established midway and on line.

C. Description of monument for corner and accessories established to perpetuate locating the position of the corner:

C1	C2	8	12
Set 1" ID x 36" iron pipe with aluminum cap.	Set 1" x 32" iron pipe with 4" aluminum cap.	Set 1" ID x 36" iron pipe with 4" aluminum cap.	Set 1" x 32" iron pipe with 4" aluminum cap.
8" sugar S37W 6.8' S6 NBT	7" sugar N21W 1.2' 1/4s NBT	4" sugar squared S79E 1.4'	7" sugar N19W 6.2' 1/16s BT
5" sugar N53E 23.0' S32 NBT	5" sugar N61W 19.4' 1/4s NBT	10" sugar N59W 26.9' 1/16s BT	6" sugar N57E 18.0' 1/16s BT
4" sugar N10W 15.6' S31 NBT	5" sugar S45W 18.5' 1/4s NBT	10" sugar S53W 25.5' 1/16s BT	6" sugar S54E 14.1' 1/16s BT
	5" sugar S65E 37.9' 1/4s NBT	7" sugar S34E 11.2' 1/16s BT	4" sugar S58W 7.6' 1/16s BT
		5" sugar N17E 17.3' 1/16s BT	

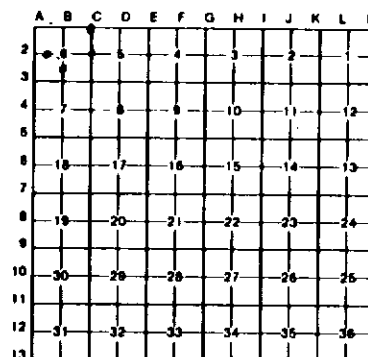

Signed by

Keith Sackett

Date

July 1, 1991

Surveyor's Michigan License No.

19006

