

LAND CORNER RECORDATION CERTIFICATE
Filing Requirement of Act 74, Mich. P.A. 1970 as Amended

For corners in

Dickinson	Located In:	Corner Code #
(County)		
Felch Township		
1. Public Land Survey	T 42N R 29W	106
	T 42N R 29W	107
	T R	
2. Property Controlling in Section	S T R	
	S T R	
	S T R	
3. Miscellaneous Property in Sec.	S T R	
	S T R	
4. Lot No. , Recorded Plat		
5. Private Claims		

Register of Deeds Stamp & File Number

	A	B	C	D	E	F	G	H	I	J	K	L	M
1													
2	6		5		4		3		2		1		
3													
4	7		8		9		10		11		12		
5													
6	18		17		16		15		14		13		
7													
8	19		20		21		22		23		24		
9													
10	30		29		28		27		26		25		
11													
12	31		32		33		34		35		36		
13													

I, Jeremy J. Pipp, in a field survey on 7/26/2012AD do hereby state that under requirements of P.A. 74, Michigan P.A. of 1970, the corner points mentioned in lines 1 and 2 above were in conformance with regulations and rules therefore as required in the current manual of survey instructions of the United States Department of the Interior, Bureau of Land Management or by a decree of a Court of Law and /or that the corner points mentioned in lines 3, 4 and 5 above were in conformance with the rules of the Michigan Board of Land Surveyors or by a Decree of a Court of Law; established, re-established, monumented, recovered, found as expressed below:

NOTE: Not more than 2 corners, all in the same town and range, may be recorded on this certificate.

A. Description of original monument and accessories and/or subsequent restoration:

(I06) Quarter corner common to Sections 14 and 15. 1849: John Burt,DS. Set Sugar post witnessed by Y. Birch 16 S30W 66 links (43.56'), Sugar 18 N34E 37 links (24.42').

(I07) Corner common to Sections 14, 15, 22, and 23. 1849: John Burt,DS. Set Cedar post witnessed by Cedar 14 N60E 44 links (29.04'), Cedar 16 S58W 24 links (15.84').; 1976: Michigan DNR (Arthur Enger PS#13581) set DNR monument (in place of a found 1" Drill Rod) witnessed by: 10" Sugar Maple N14W 33.3', 4" Sugar Maple S60W 34.1'.

B. Description of corner evidence found and/or method applied in restoring or reestablishing corner:

(I06) Accepted found bent 1 1/2" pipe as monumenting said corner location; checks excellent with calculated proportionate position. Set MDNR monument in place of said existing monument and witnessed. Position is accepted as a careful and faithful REESTABLISHMENT of the position of the original corner.

(I07) Accepted found MDNR Monument and existing NBT Witness (one living). Left MDNR monument in place and rewitnessed. Accepted found MDNR Monument and Witness as a careful and faithful REESTABLISHMENT of the position of the original corner.

C. Description of monument for corner and accessories established to perpetuate locating the position of the corner:

(I06) DNR monument
7" Maple N43E 31.80' (1/4S,NBT)
7" Aspen N82E 5.40' (1/4S,NBT)
10" Maple S07W 44.65' (1/4S,NBT)
4" Cherry N75W 10.00' (1/4S,NBT)
All trees are blazed, scribed, painted, and signed. Measurements are to nail in side of tree, bearings are magnetic. A carsonite rail was set North 1.5 feet.

(I07) DNR monument
EX. 17" Maple N10W 33.72' (- , -)
5" Spruce S78E 38.51' (S23,NBT)
4" White Birch South 6.42' (S22,NBT)
7" White Birch S67W 20.70' (S22,NBT)
All trees are blazed, scribed, painted, and signed. Measurements are to nail in side of tree, bearings are magnetic. A carsonite rail was set South 1.5 feet.


Signed by Jeremy J. Pipp
Surveyor's Michigan License No. 50447

For the Michigan Department of Natural Resources, Fisheries, and Forestry

August 28, 2012

20094

20096

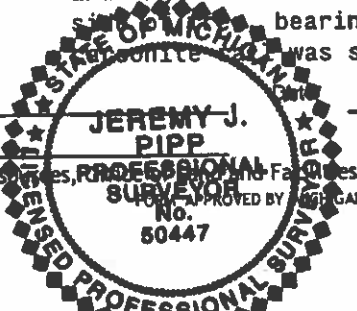

Revised May 14, 1975
Revised Jan., 1983
Revised Oct., 1995