

LAND CORNER RECORDATION CERTIFICATE
Filing Requirement of Act 74, Mich. P.A. 1970 as Amended

For corners in

Dickinson (County)
West Branch Township
1. Public Land Survey
2. Property Controlling in Section
3. Miscellaneous Property in Sec.
4. Lot No.
5. Private Claims

Register of Deeds Stamp & File Number

Table with 13 rows and 13 columns (A-M) for Register of Deeds Stamp & File Number.

I, Jeremy J. Pipp, in a field survey on 8/20/2012AD do hereby state that under requirements of P.A. 74, Michigan P.A. of 1970, the corner points mentioned in lines 1 and 2 above were in conformance with regulations and rules therefore as required in the current manual of survey Instructions of the United States Department of the Interior, Bureau of Land Management or by a decree of a Court of Law and /or that the corner points mentioned in lines 3, 4 and 5 above were in conformance with the rules of the Michigan Board of Land Surveyors or by a Decree of a Court of Law; established, re-established, monumented, recovered, found as expressed below:

NOTE: Not more than 2 corners, all in the same town and range, may be recorded on this certificate.

A. Description of original monument and accessories and/or subsequent restoration:

(12) Center-South One-Sixteenth corner of Section 25. Not set in original survey, no evidence of subsequent establishment.

(16) East One-Sixteenth corner common to Sections 25 and 36. Not set in original survey, no evidence of subsequent establishment.

B. Description of corner evidence found and/or method applied in restoring or reestablishing corner:

(12) Corner position established mid-point and on-line between the Center One-Quarter corner and the South One-Quarter corner of Section 25.


(16) Corner position established mid-point and on-line between the South One-Quarter corner and the Southeast corner of Section 25.

C. Description of monument for corner and accessories established to perpetuate locating the position of the corner:

- (12) DNR monument
5" Cedar N35E 15.67' (1/16S,BT)
7" Cedar S30E 8.72' (1/16S,BT)
9" Cedar S29W 18.76' (1/16S,BT)
14" Cedar N72W 24.11' (1/16S,BT)
All trees are blazed, scribed, and painted. Measurements are to nail in side of tree, bearings are magnetic.

(16) DNR monument
8" Maple N61E 43.66' (1/16S,BT)
6" W. Birch S59E 10.86' (1/16S,BT)
14" Spruce S57W 38.36' (1/16S,BT)
17" Spruce N46W 28.90' (1/16S,BT)
All trees are blazed, scribed, and painted. Measurements are to nail in side of tree, bearings are magnetic.

Signed by [Signature]
Surveyor's Michigan License No. 50447
For the Michigan Department of Natural Resources, Office of Professional Surveyors

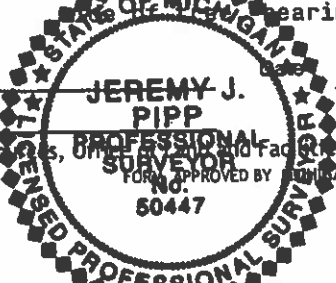

August 29, 2012