

LAND CORNER RECORDATION CERTIFICATE
Filing Requirement of Act 74, Mich. P.A. 1970 as Amended

For corners in

Dickinson Located In: Corner Code #
WEST BRANCH TOWNSHIP
1. Public Land Survey
2. Property Controlling in Section
3. Miscellaneous Property in Sec.
4. Lot No. , Recorded Plat
5. Private Claims

Register of Deeds Stamp & File Number

Table with 13 rows and 13 columns (A-M) containing numbers 1-36 and a central dot at row 2, column I.

6/24/2013AD
Jeremy J. Pipp, in a field survey on 6/24/2013AD do hereby state
that under requirements of P.A. 74, Michigan P.A. of 1970, the corner points mentioned in lines 1 and 2
above were in conformance with regulations and rules therefore as required in the current manual of survey
instructions of the United States Department of the Interior, Bureau of Land Management or by a decree of
a Court of Law and /or that the corner points mentioned in lines 3, 4 and 5 above were in conformance with
the rules of the Michigan Board of Land Surveyors or by a Decree of a Court of Law; established,
re-established, monumented, recovered, found as expressed below:

NOTE: Not more than 2 corners, all in the same town and range, may be recorded
on this certificate.

A. Description of original monument and accessories and/or subsequent restoration:

(H03) Quarter corner common to Sections 3 and 10. 1850: John Burt,DS. Set Tamarack
post witnessed by Spruce 10 N45E 6 links (3.96'), Cedar 8 S40W 38 links (25.08').

(I02) Quarter corner common to Sections 2 and 3. 1850: John Burt,DS. Set Quarter
Section post witnessed by Hemlock 14 S40W 12 links (7.92'), Y. Birch 16 N41E 18 links
(11.88'). 1963: Michigan DNR (Billy Buckler PS#8887) Set 1" Pipe with 4"aluminum cap
witnessed by 28" W. Pine S80W 25 1/2 links (16.83'), 5" Hard Maple S09E 21 links
(13.86').

B. Description of corner evidence found and/or method applied in restoring or reestablishing corner:


(H03) No evidence of original survey. Found squared Cedar trees in vicinity (East 26
feet & S60E 34' from calculated single proportionate position). Corner position
reestablished by single proportionate measurement between the Northwest corner and the
Northeast corner of Section 10. Position is accepted as a careful and faithful
REESTABLISHMENT of the position of the original corner.

(I02) Accepted found MDNR Monument and Maple NBT as a careful and faithful PERPETUATION
of the position of the original corner. Additional check applicable if 1964 NBT witness
was interpreted as White Pine S80W 52 1/2 links (not 25 1/2).

C. Description of monument for corner and accessories established to perpetuate locating the position of the corner:

(H03) DNR monument
11" Tamarack N01E 46.08' (1/4S,NBT)
6" Tw. Cedar East 24.12' (1/4S,NBT)
7" Cedar S60E 33.87' (1/4S,NBT)
5" Cedar S75W 19.51' (1/4S,NBT)
All trees are blazed, scribed, painted,
and signed. Measurements are to nail in
side of tree, bearings are magnetic. A
carsonite rail was set North 1.5 feet.
(I02) DNR monument
4" Maple N10E 12.95' (1/4S,NBT)
4" Maple N87E 10.47' (1/4S,NBT)
EX. 15" Maple S02W 13.80' (1/4S,NBT)
39" W. Pine S86W 33.68' (1/4S,NBT)
All trees are blazed, scribed, painted,
and signed. Measurements are to nail in
side of tree, bearings are magnetic. A
carsonite rail was set North 1.5 feet.

Signed by
Surveyor's Michigan License No. 50447

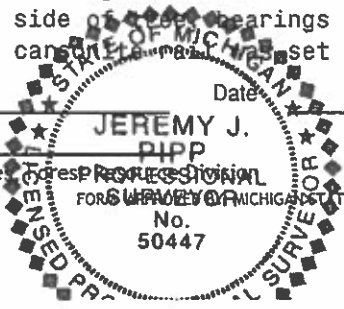

Date August 08, 2013

For the Michigan Department of Natural Resources