

LAND CORNER RECORDATION CERTIFICATE
Filing Requirement of Act 74, Mich. P.A. 1970

For corners in

Dickinson
(County)

Located In:

Corner Code #

FELCH TOWNSHIP
1. Public Land Survey

T 43 R 28

G-12

2. Property Controlling
In Section

S

T

R

3. Miscellaneous
Property in Sec.

S

T

R

S

T

R

S

T

R

S

T

R

4. Lot No. _____, Recorded Plat _____

5. Private Claims _____


RECORDED

1978 DEC 14 PM 4:30

REGISTER OF DEEDS
DICKINSON COUNTY
RON MOORE, CLERK

SURVEY &
REMONUMENTATION

MAR 26 1999

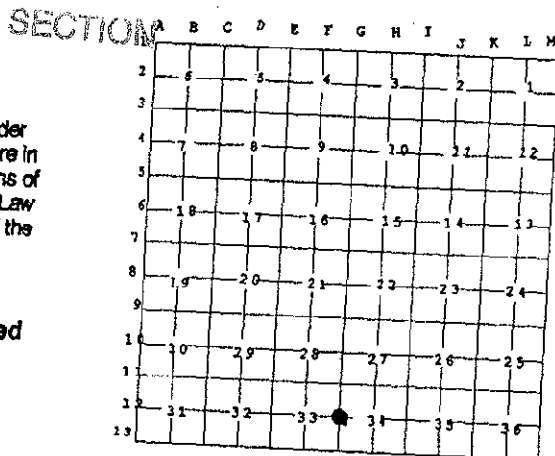

I, STEVEN APPLEKAMP, in a field survey on JUNE 17, 1998, do hereby state that under requirements of P.A. 74, Michigan P.A. of 1970, the corner points mentioned in lines 1 and 2 above were in conformance with regulations and rules therefore as required in the current manual of survey instructions of the United States Department of the Interior, Bureau of Land Management or by a decree of a Court of Law and/or that the corner points mentioned in lines 3, 4 and 5 above were in conformance with the rules of the Michigan Board of Land Surveyors or by a Decree of a Court of Law; established, re-established, monumented, recovered, found as expressed below:

NOTE: Not more than 2 corners, all in the same town and range, may be recorded on this certificate

NOTE: SEE REVERSE SIDE FOR SECTION SUBDIVISION

A. Description of original monument and accessories and/or subsequent restoration:

ORIGINAL CORNER ESTABLISHED BY J. BURT - SEPT., 1850

ORIGINAL CORNER: WOOD POST

ORIGINAL BEARING TREES:

TAMARACK 12" S 55° E 7 LINKS (4.82 feet)

TAMARACK 10" N 80° W 18 LINKS (11.68 feet)

ACCEPTED BY THE DICKINSON COUNTY
SURVEY PEER GROUP AS THE OFFICIAL
CORNER UNDER MICHIGAN PUBLIC ACT
345 OF 1990 AT A MEETING HELD ON
12-7-98

RAP
COUNTY REPRESENTATIVE

B. Description of corner evidence found and/or method applied in restoring or reestablishing corner:

FOUND ORIGINAL CORNER POST POINT 2 FEET BELOW GROUND ALSO FOUND ORIGINAL BEARING TREE BLAZE (S 55° E 4.8 feet) WITH THE LETTER "T" RAISED IN THE OVER GROWN PART OF THE TREE. I SET THE QUARTER CORNER POSITION AT THE POST POINT LOCATION WITH A 5' LONG x 1" ALUMINUM PIPE.

C. Description of monument for corner and accessories established to perpetuate locating the position of the corner:

AT THE POST POINT LOCATION I SET A 1" x 60" ALUMINUM ROD WITH A DICKINSON COUNTY ALUMINUM CAP, FROM WHICH I ESTABLISHED THE FOLLOWING NEW

BLAZED AND SCRIBED BEARING TREES:
(all measurements taken to nail set in tree)

CEDAR	6"	N 38° E	6.59 feet
CEDAR	6"	N 88° E	6.58 feet
CEDAR	7"	S 15° E	7.88 feet
CEDAR	6"	S 80° W	4.73 feet
CARSONITE RAIL		NORTH	1.08 feet



Signed by Steven Applekamp

Surveyor's Michigan License No. B.S. 43045

Date Nov 30th 98

MAR 26 1999

SECTION

